


T. 22S., R. 33E., W.M.

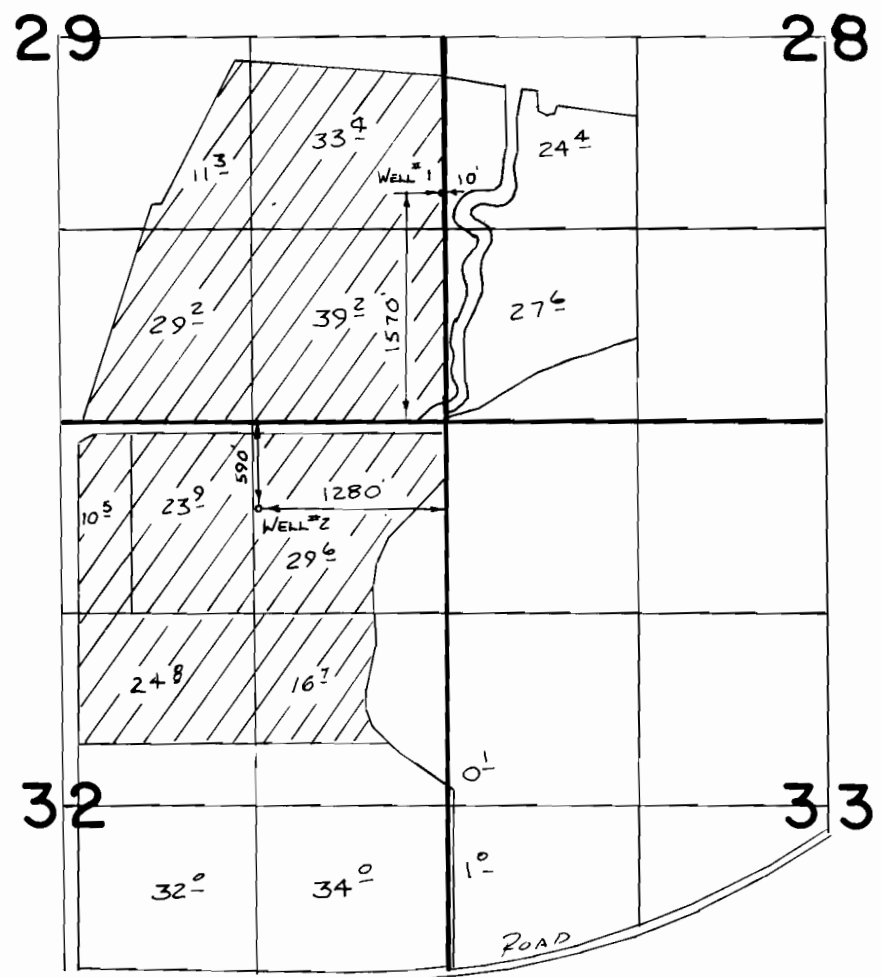

SCALE 1"=1320'

FINAL PROOF SURVEY
UNDER

Application No. **G-10206** Permit No. **G-9310**...
IN NAME OF

JOHN C. & JOYCE A. LAGLER...

Surveyed **5-7**..... 19**88**, by **D. SALEN**.....