


T.27S., R.6W., W.M.

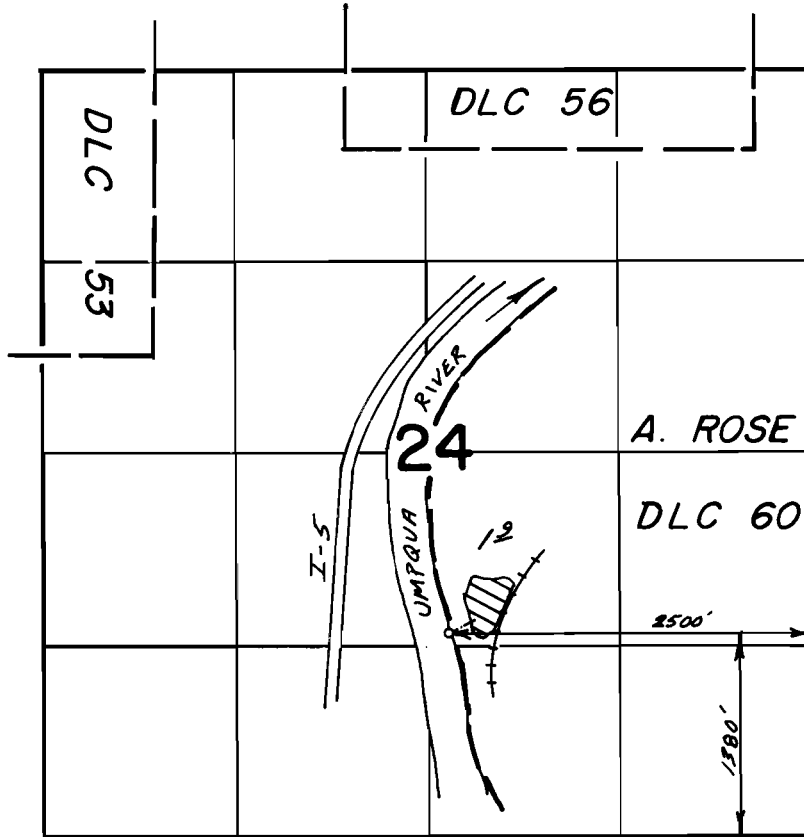

Scale 1" = 1320'

**FINAL PROOF SURVEY**  
UNDER

Application No. ~~54840~~ Permit No. 41139.....  
IN NAME OF

.....CITY OF ROSEBURG.....

Surveyed June 21, 1982, by L. TOLL.....  
Sept. 25, 1984 by L. CASHION