


T. 39 S., R. 7 W., W. M.

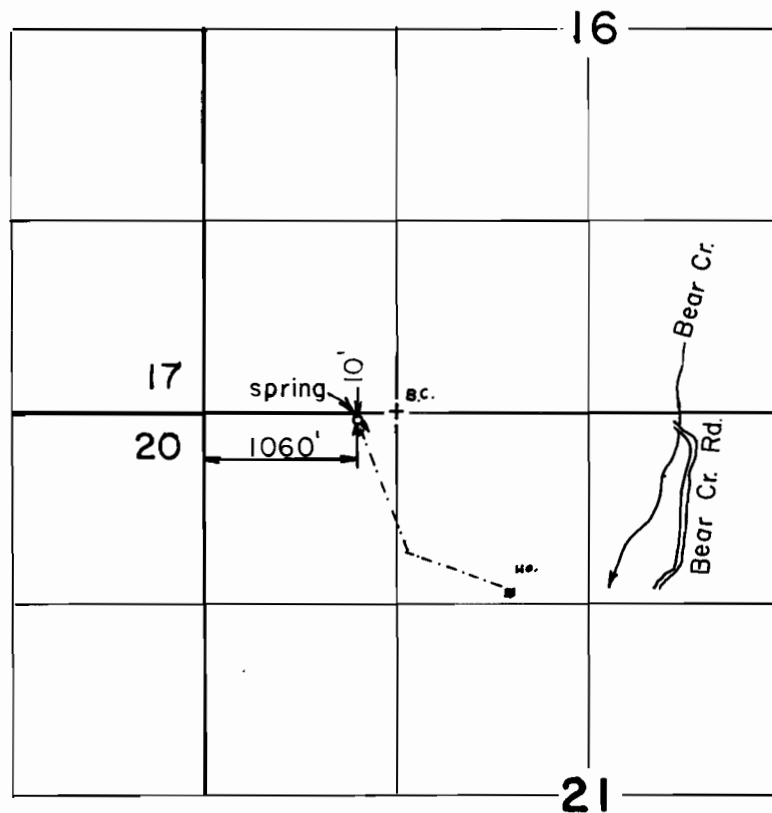

Scale: 1" = 1320'

FINAL PROOF SURVEY
UNDER

Application No. 55006 Permit No. 41318.....
IN NAME OF

..KRIS...and...SANDY...HALASZ...

Surveyed SEP...6.. 1990, by B...S...JAMES..