


T.34S., R.7E., W.M.

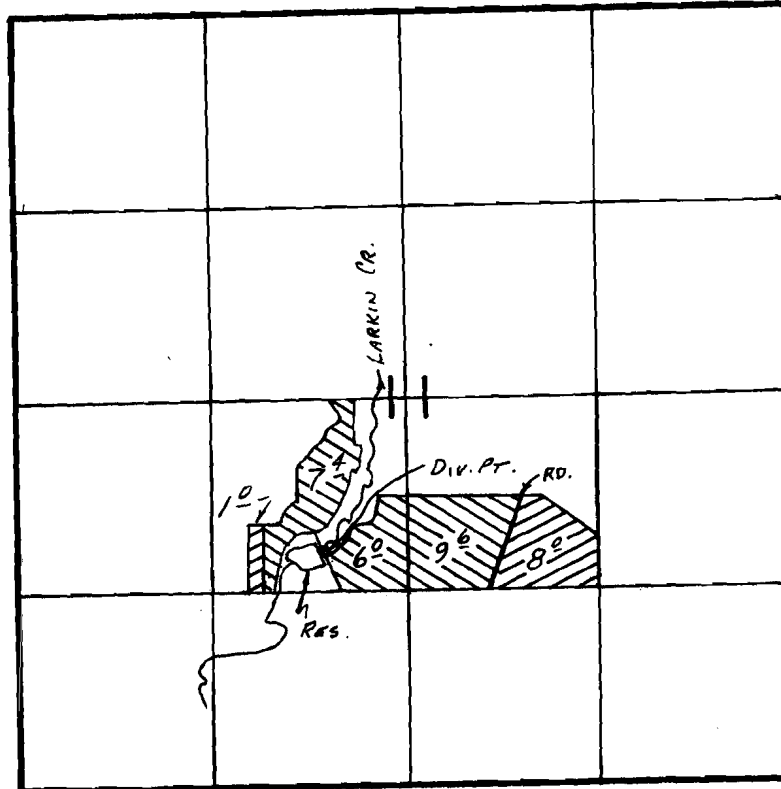

Div. Pt. Loc.: 1640' N. & 2050' E. FROM SW COR. SEC. 11

SCALE: 1" = 1320'

**FINAL PROOF SURVEY
UNDER**

R-55426

R-6680

55427

42133

Application No. 57628 Permit No. 43586



IN NAME OF

.....DONALD G. KELLER.....

Surveyed Sept. 14, 1986, by B.W. BISHOP.....

William B. Bishop, S. Marsh Plac.