


7x100  
67678

T.34S., R.7E., W.M.

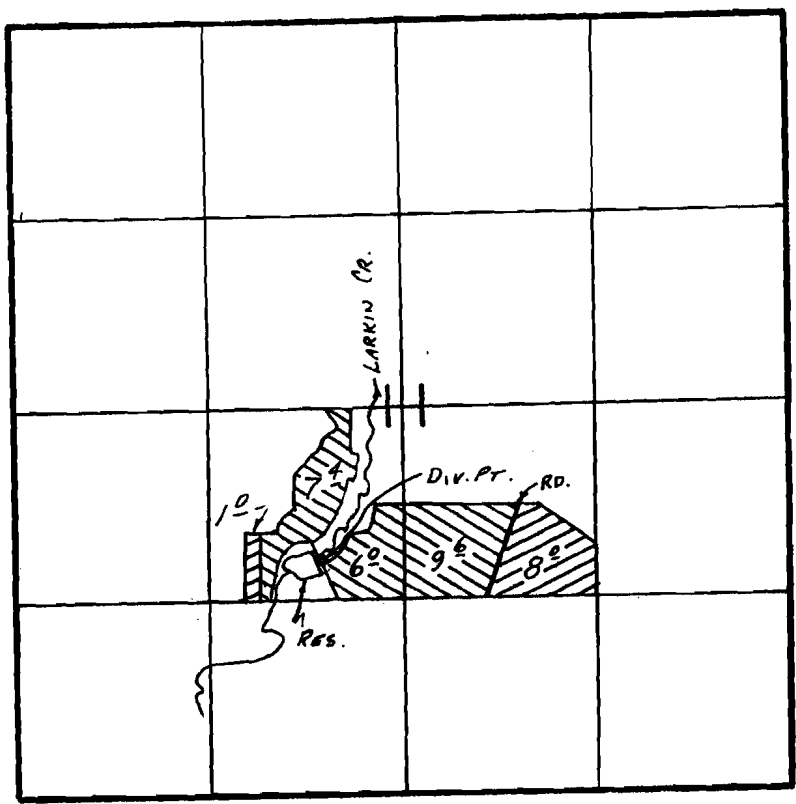

DIV. PT. LOC.: 1640' N. & 2050' E. FROM SW COR. SEC. 11

SCALE: 1" = 1320'

### FINAL PROOF SURVEY UNDER

R-55426                      R-6680  
55427                          42133

Application No. 57628    Permit No. 43586



IN NAME OF

.....DONALD G. KELLER.....

Surveyed Sept. 14. 1986, by B.W. BISHOP.....

W.B. Bishop, K. Marsh & Marsh