


T.34S., R.7E., W.M.

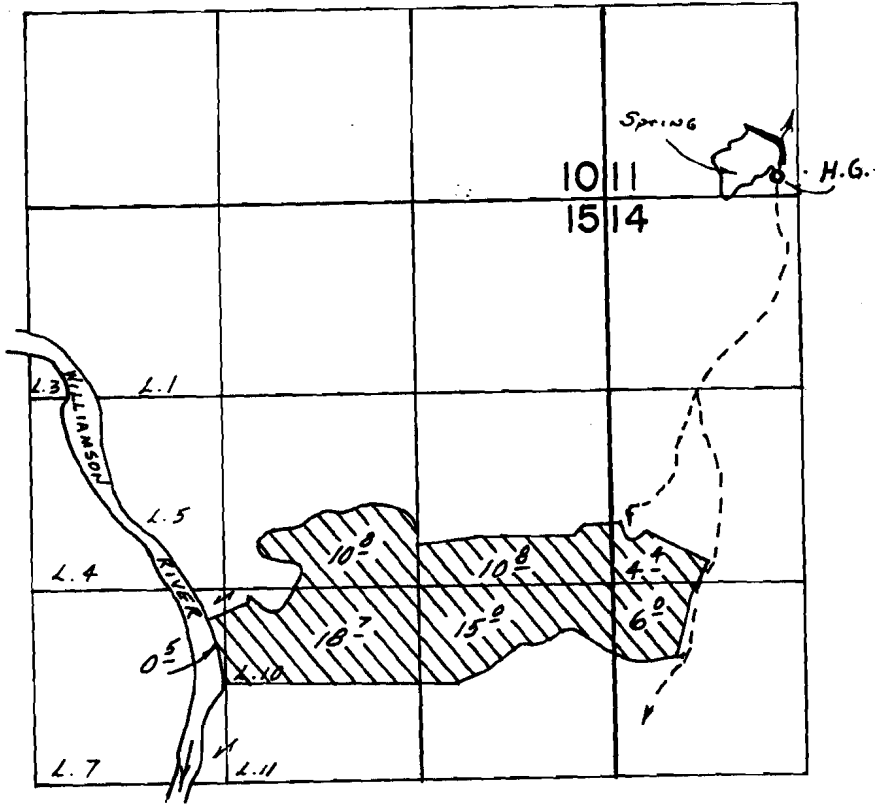

Div. Pt. LOC.: 350' N. & 1200' E. FROM SW COR SEC. 11

SCALE: 1" = 1320'

**FINAL PROOF SURVEY
UNDER**

Application No. 55869. Permit No. 41909.....
IN NAME OF

.....BYRON ERKENBRECHER.....

Surveyed Sept. 12. 1986, by B.W. BISHOP...

W.L. By. blw. K. Marsh's Div.