


T. 26 S., R. 6 W., W.M.

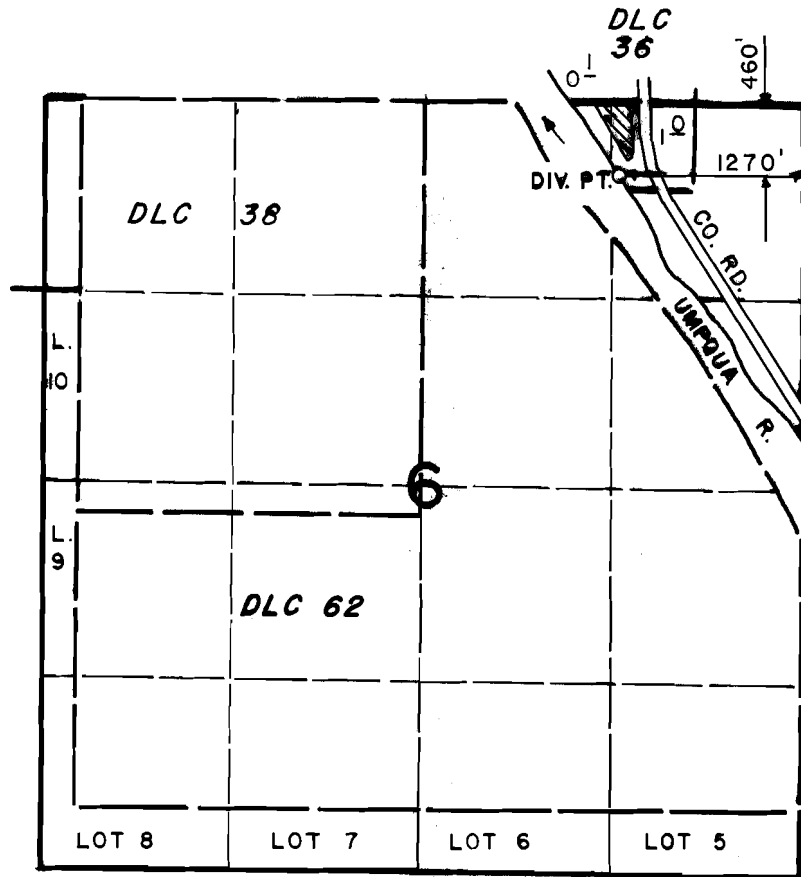

SCALE: 4" = 1 MILE
FINAL PROOF SURVEY
UNDER

Application No. 57096.. Permit No. 43059.....
IN NAME OF

.....**WILLIAM BEN WAWRO**.....

Surveyed OCT. 15.. 1985., by J.M. SCHMORDE