


T18S RIW WM

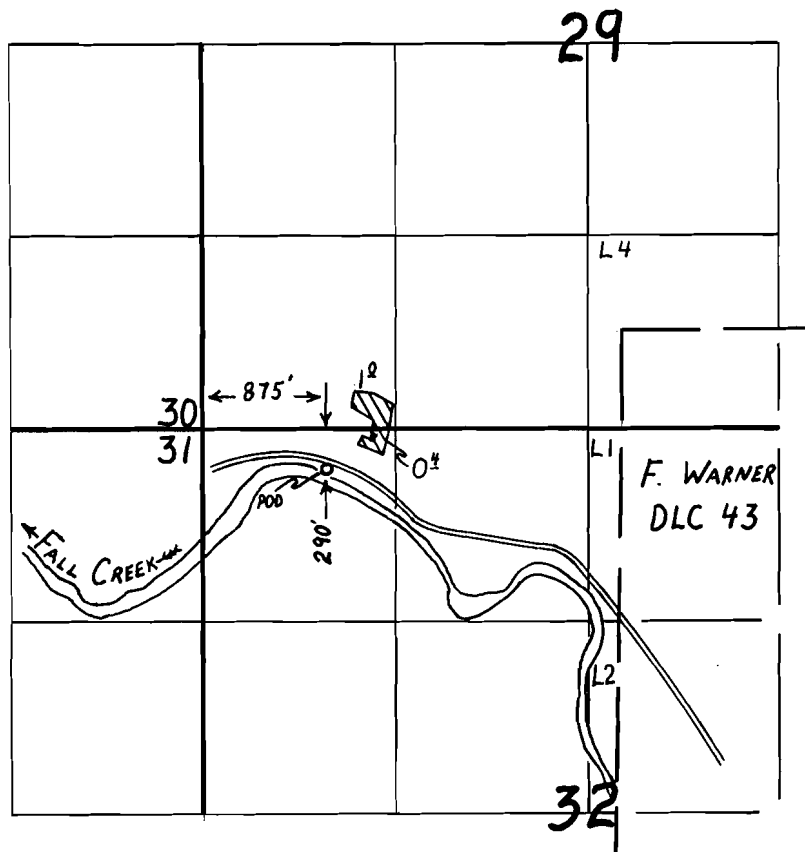

1" = 1320'

FINAL PROOF SURVEY UNDER

Application No. 61253 Permit No. 45580..
IN NAME OF

J. T. WILSON

Surveyed Aug. 21... 1990.., by T. M. WARREN...