
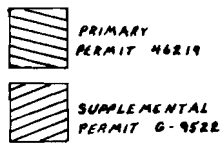


T. 6 S., R. 1 W., W.M.

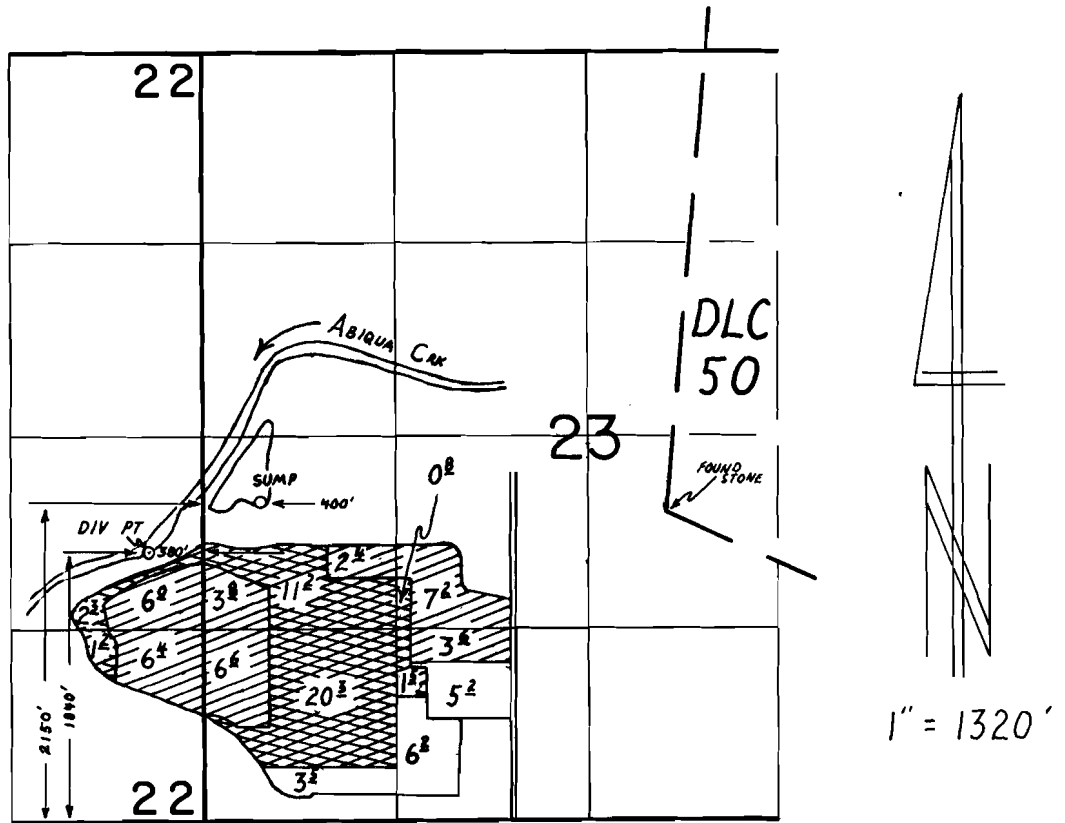

FINAL PROOF SURVEY

UNDER

61427

46219

Application No. G 10224 Permit No. G 9522

IN NAME OF

PEMBROKE FARMS

Surveyed MAY 21, 1990, by T.M. WARREN