


Application No. 63922
Permit No. 48694

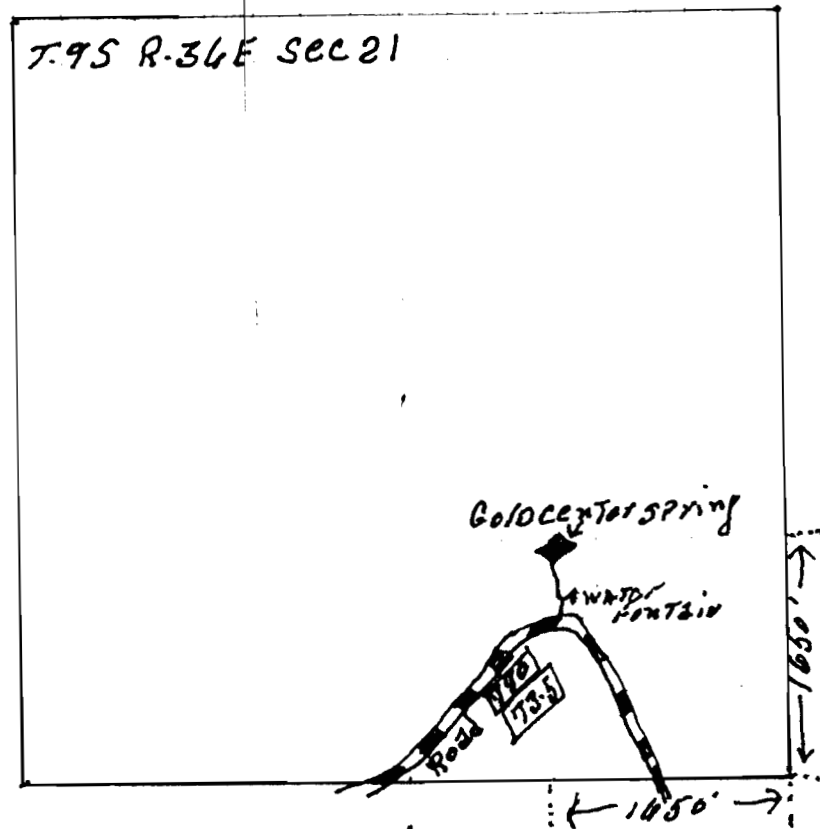

RECEIVED

MAR 25 1983
WATER RESOURCES DEPT.
SALEM, OREGON

4" = 1 mile

RECEIVED

AUG 23 1982
WATER RESOURCES DEPT.
SALEM, OREGON