


T. 39 S., R. 6 & 7 W., W. M.

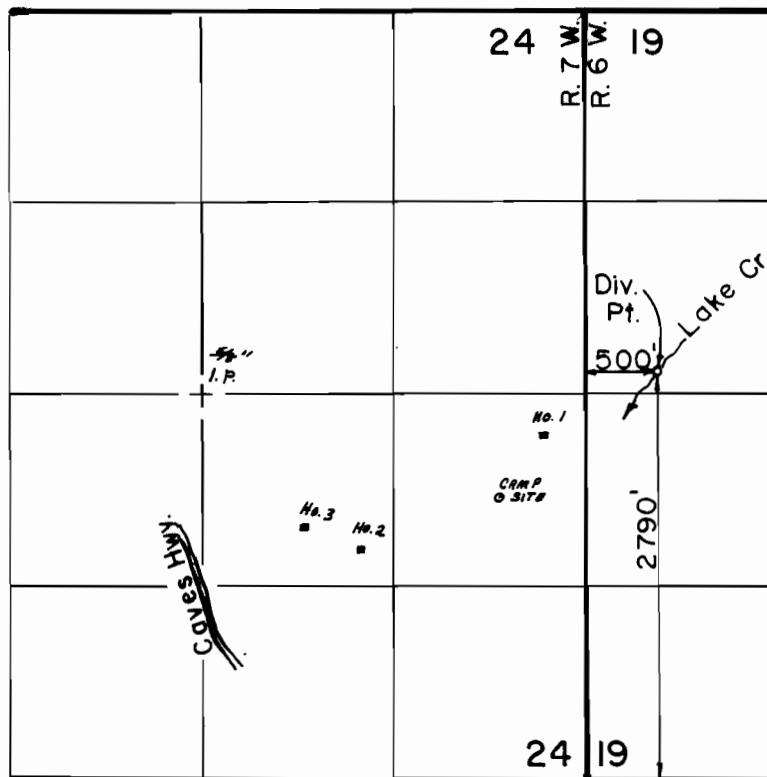

Scale: 1" = 1320'

FINAL PROOF SURVEY
UNDER

Application No. 65029 Permit No. 47781....
IN NAME OF

.....MICHAEL D. GROTHE.....

Surveyed JUL 18, 1990, by B. S. JAMES...