

Township 24 South Range 8 East Will. Met.


708

STATE ENGINEER
RECEIVED

OCT 6 1924

N

SALEM, OREGON

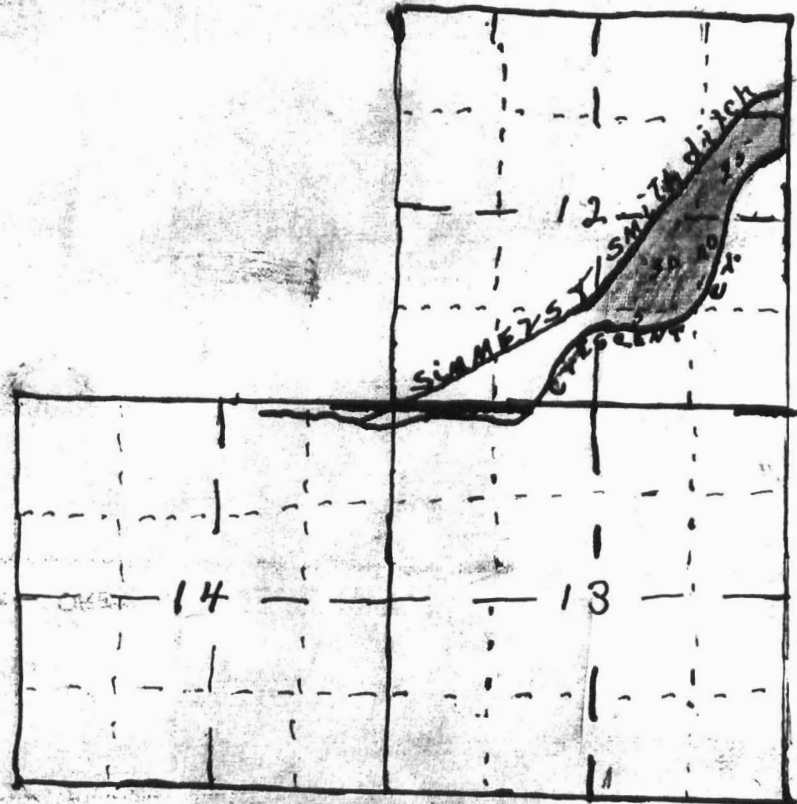

2
8
0
✓

Application No. 9867
Permit No. 6542

C-6769

Application No. 9867
Permit No. 6542

6542