


T. 25 S., R. 6 W., W.M. SECTION 1

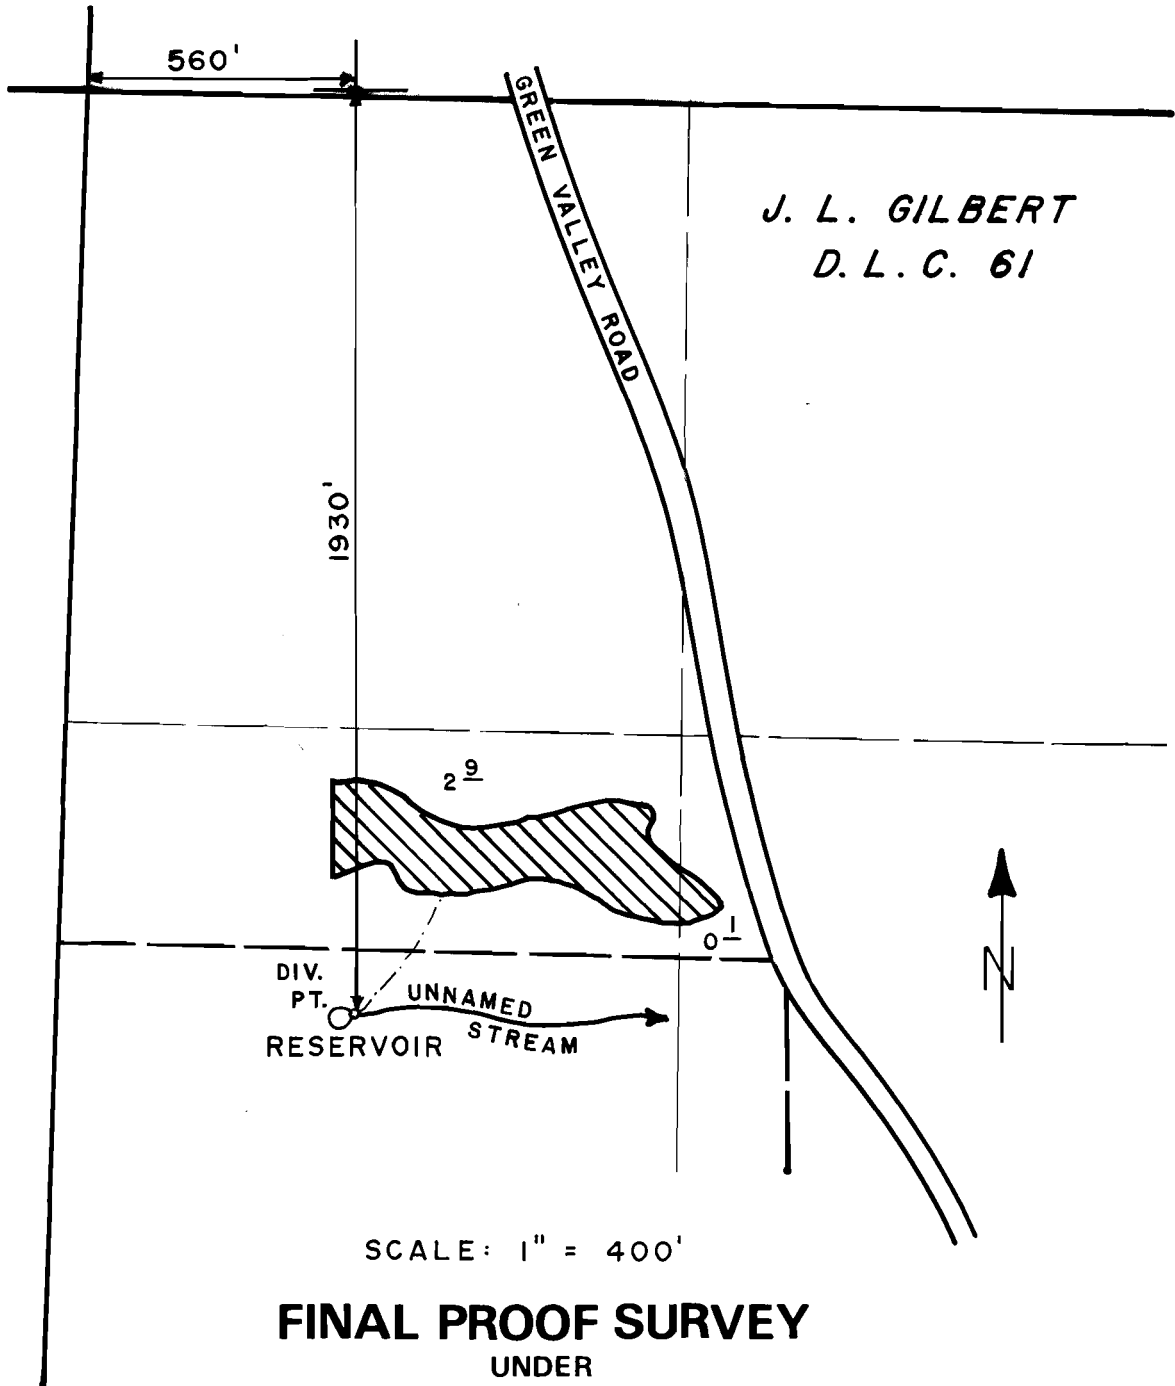

J. L. GILBERT
D. L. C. 61

FINAL PROOF SURVEY UNDER

R-65596 R-8991
Application No. 65597. Permit No. 48004....
IN NAME OF

LOREN R. BARNETT

Surveyed JULY 14 1986, by J. M. SCHMORDE
SEPT. 19, 1991, B. S. JAMES