


T. 39 S., R. 8 W., W. M.

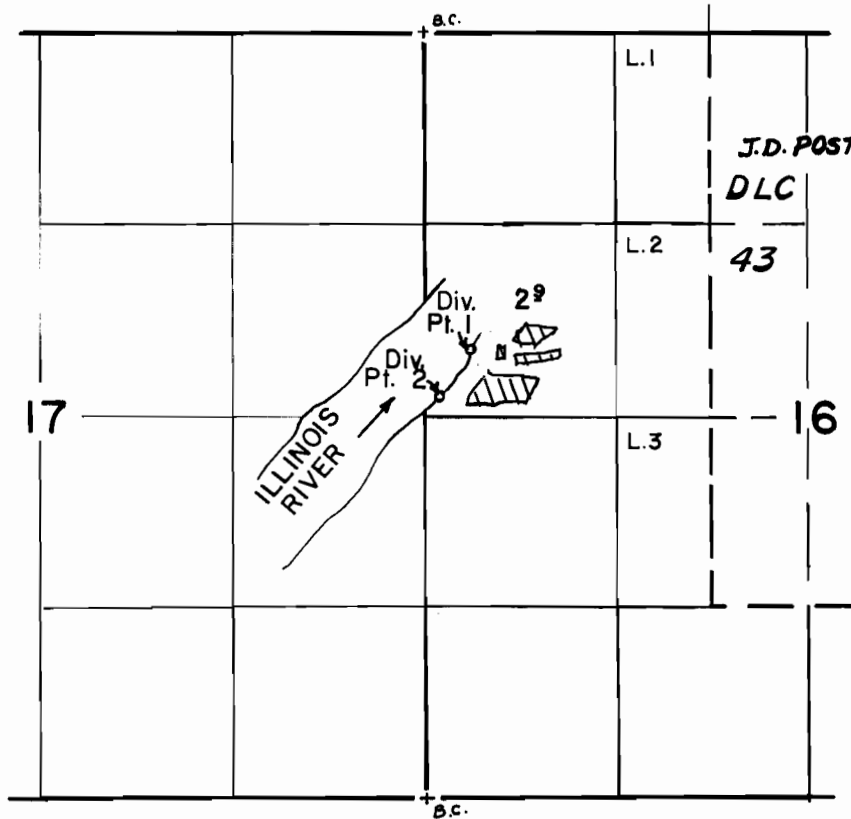

Div. Pt. 1: 2170' S., 300' E.,  
Div. Pt. 2: 2500' S., 100' E.,  
both from NW cor. of Sec. 16

Scale: 1" = 1320'

### FINAL PROOF SURVEY UNDER

Application No. 68129.. Permit No. 49346...  
IN NAME OF

ROLLAND H. & MAE S. CARR

Surveyed MAY. 24. 1990., by B. S. JAMES...  
& DEC. 10, 1991