


RECEIVED

MAY 14 1985

WATER RESOURCES DEPT.
MORROW COUNTY

Application No. 68626
Permit No. 49594

T4S. R.28E. W.M.

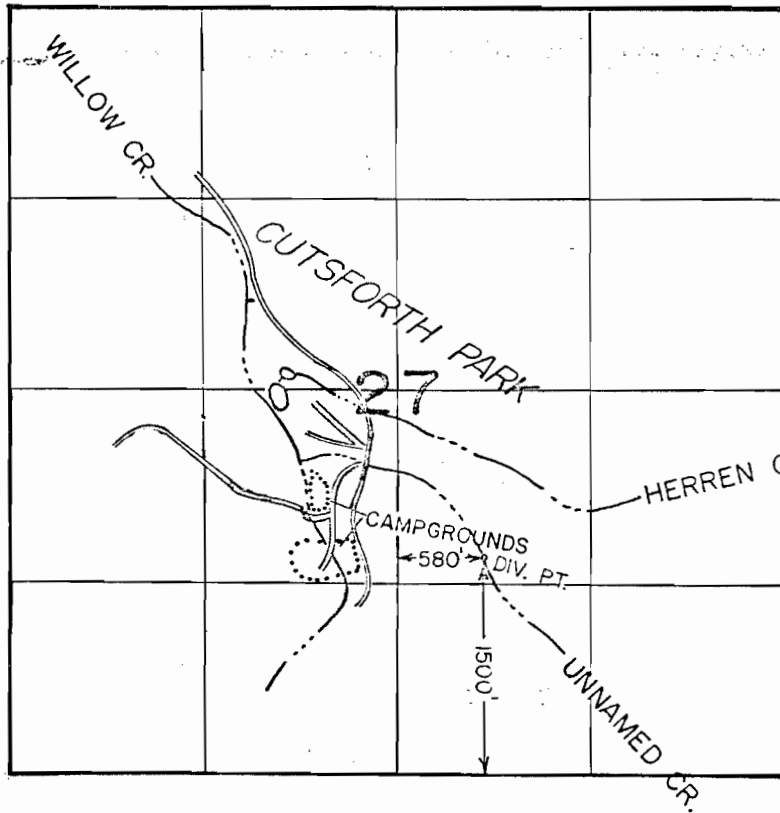

SCALE 1" = 1320'



IN NAME OF

MORROW COUNTY

LAN