


DISTANCE TO OUTLET CONTROL STRUCTURE FROM E. 1/4 CORNER OF SECTION 32

	SOUTH	WEST
MURRAYHILL RESERVOIR	200'	65'

AREA OF RESERVOIR LOCATED IN S.E.1/4 N.E.1/4; N.E.1/4 S.E.1/4, SECTION 32

MURRAYHILL RESERVOIR	AREA
	3.7 ACRES

SURVEYED BY

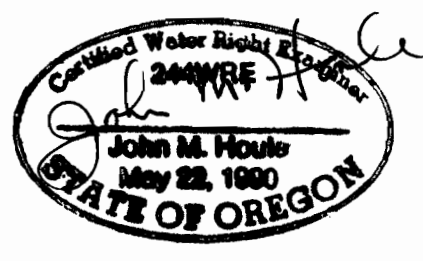

THIS MAP IS FOR THE PURPOSE OF IDENTIFYING THE LOCATION OF THE WATER RIGHT ONLY AND IS NOT INTENDED TO PROVIDE LEGAL DIMENSIONS OR LOCATION OF PROPERTY OWNERSHIP LINES

JOB NO 2886

FINAL PROOF SURVEY
 UNDER APPLICATION R-68977 AND 70245, PERMIT R-11252 AND 51089
 (MURRAYHILL)
 SECTION 32, T.1S, R.1W, W.M.

APPLICANT: COLUMBIA WILLAMETTE DEVELOPMENT COMPANY
 14780 S.W. OSPREY, SUITE # 240
 BEAVERTON, OREGON 97007 (503) 646-7115

otak INC. ARCHITECTS, P.C.
 incorporated
 17355 S.W. Boones Ferry Rd, Lake Oswego, OR 97035. (503) 635-3618
 101 E. 8th Street, Vancouver, WA 98660. (206) 695-0357
 25 Central Way, #305, Kirkland, WA 98033. (206) 822-4446