


T.23S..R.12W..W.M.

PREPARED BY:
STUNTZNER ENG. & FOR.
P.O. BOX 118/705 S 4th
COOS BAY, OREGON

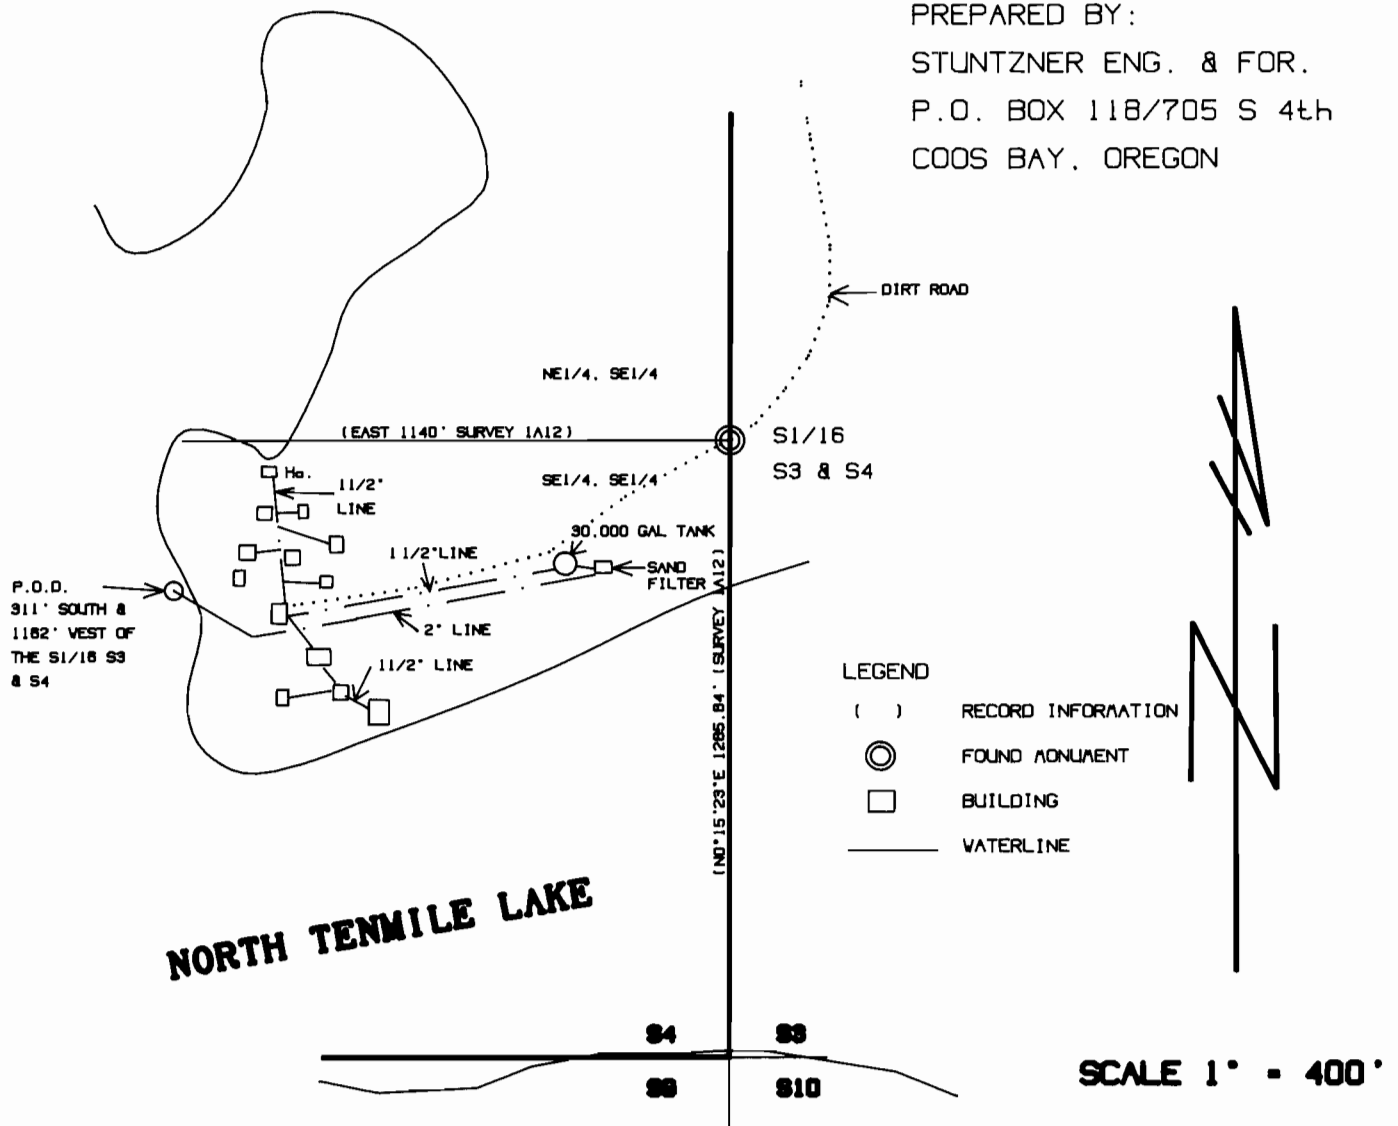

EXAMINERS DISCLAIMER STATEMENT

THE PREPARATION OF THIS MAP WAS FOR THE PURPOSE OF IDENTIFYING THE LOCATION OF THE WATER RIGHT ONLY AND HAS NO INTENT TO PROVIDE DIMENSIONS OR LOCATION OF OWNERSHIP LINES.

FINAL PROOF SURVEY

Application No. 70387... Permit No. 51120....

IN NAME OF

.....THE EASTER SEAL SOCIETY OF OREGON.....

Surveyed MY..... 1991... by H.A. VILCOX

