


T26S. R4W.WM

SCALE 1" = 1320'

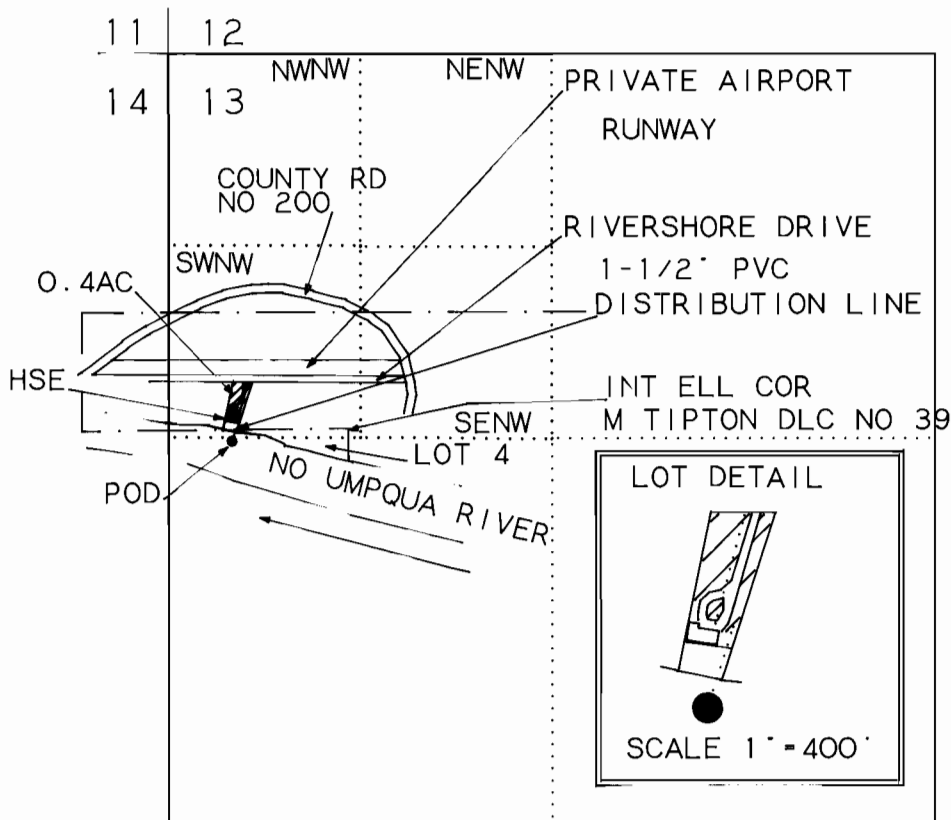

POD IS 2660 FT S AND 450 FT E FROM NW COR S 13

FINAL PROOF SURVEY

UNDER

Application No. 70408 Permit No. 51029

IN NAME OF

DOC OR ISABEL ADAMS

Surveyed September 20, 1990 by M E Farr

