

1" = 400'

TWP. 16S. R. 7 W.W.M.  
SECTION 3  
FINAL PROOF SURVEY  
UNDER  
APPLICATION NO. 70775 PERMIT NO. 51184  
IN THE NAME OF  
DAVID S. AND  
BERNADINE PETE



CHARLES W. GUILÉ  
& ASSOCIATES, CO.  
Land Surveying  
62 Centennial Loop  
Eugene, OR 97401


SCALE,  
1" = 400'

SURVEY JUNE 13, 1991 BY Charles W. Guile  
REVISED MARCH 31, 1992

DIVERSION POINT NO. 1  
380.64 FT. NORTH & 1617.66 FT  
EAST SW COR SEC 3

THIS MAP IS FOR WATER  
RIGHT PURPOSES ONLY  
AND IS NOT INTENDED TO  
PROVIDE DIMENSIONS TO  
LOCATE PROPERTY  
BOUNDARIES.

DIVERSION POINT NO. 2  
317.30 FT. NORTH & 2122.66  
FT. EAST SW COR. SEC. 3.

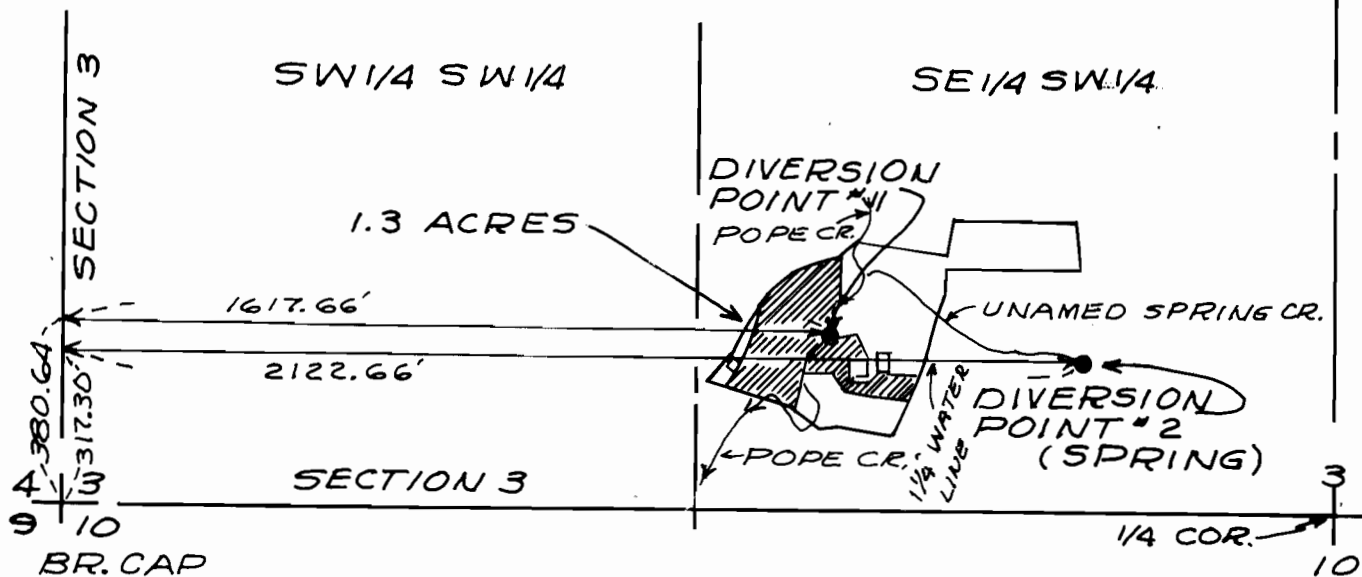

84-20A