


# T. 38 S. R. 9 W. W.M.

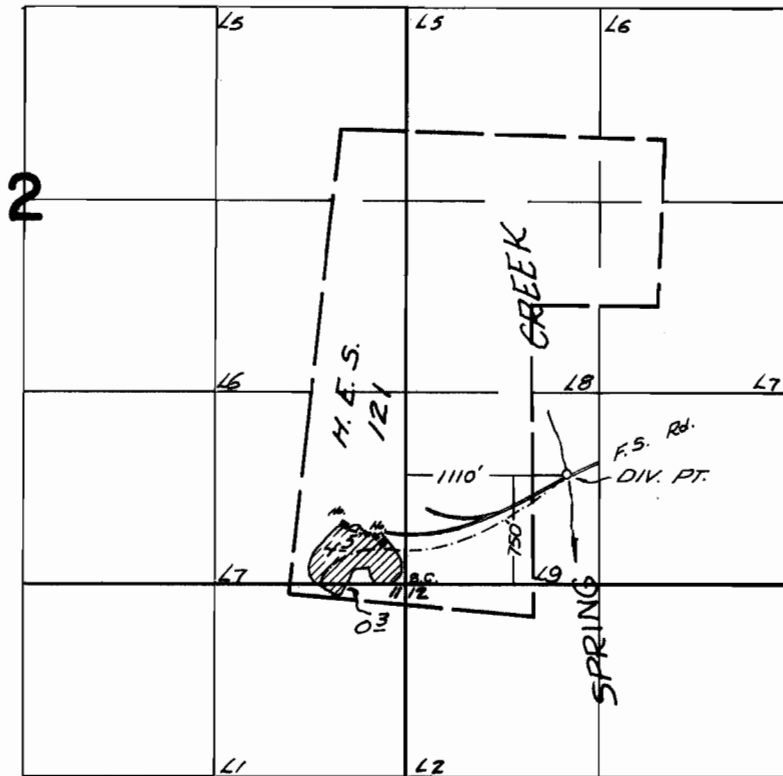

## FINAL PROOF SURVEY UNDER

Application No. 38536 Permit No. 28674  
IN NAME OF

JACK LIONBERGER

Surveyed May 19 1967, by V. Garner