


# T.36S., R.14E., W.M.

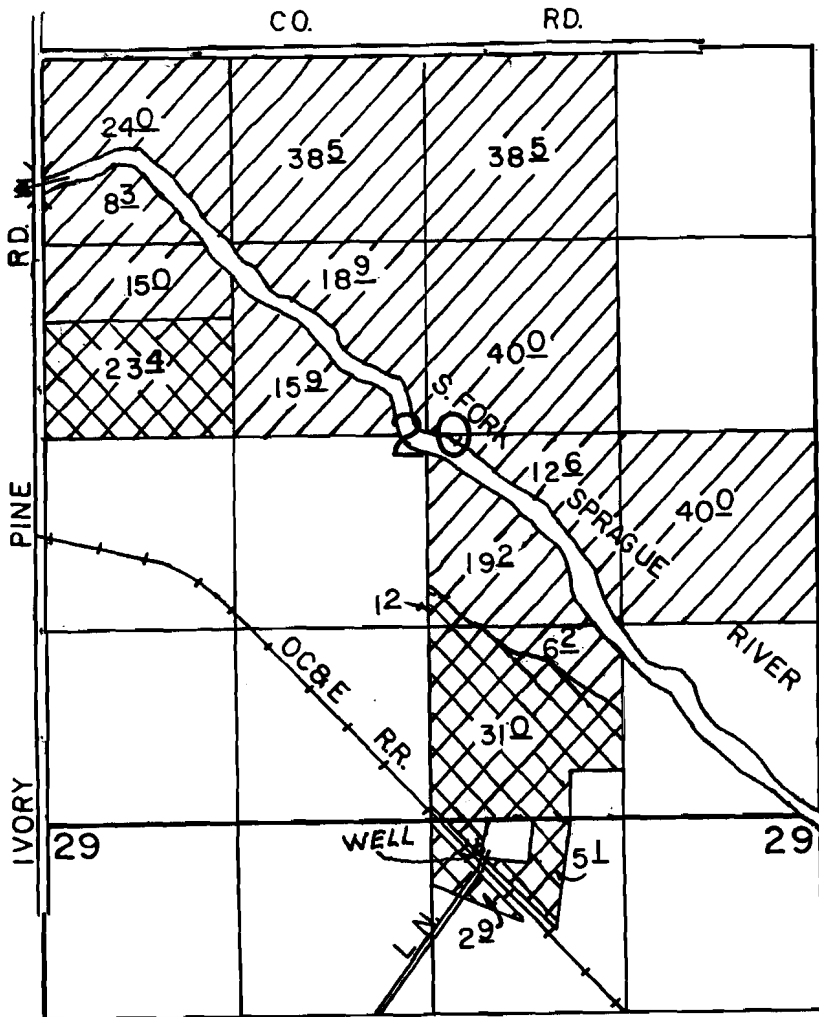

WELL LOC.: 200' S. & 3000' E. FROM NW COR. OF SEC. 29.

SCALE: 1" = 1320'

## FINAL PROOF SURVEY UNDER

 SUPPLEMENTAL

 PRIMARY

Application No. G-9235 Permit No. G-8603  
IN NAME OF

RODNEY L. HADLEY

Surveyed APR. 24. 1991., by B. W. BISHOP...

*U.S. Sprague to Mer. 1/1/11*