


T.22S., R.30E., W.M.

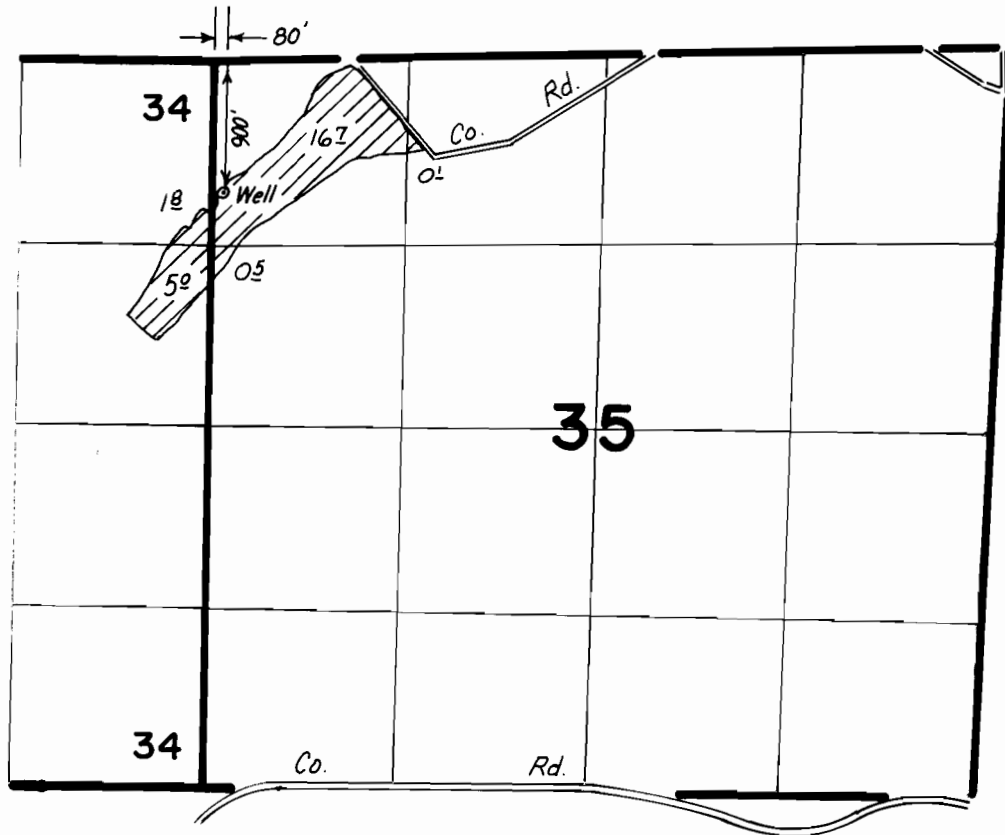


FINAL PROOF SURVEY
UNDER

Application No. **G9052**. Permit No. **G8595**.....
IN NAME OF

CLARENCE...HERBERT...HENNINGS.....

Surveyed ...5...7... 1988., by *Mike...Schmorde*

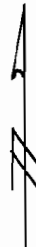

Scale: 1" = 1320'