


T. 27S., R. 34E., W.M.

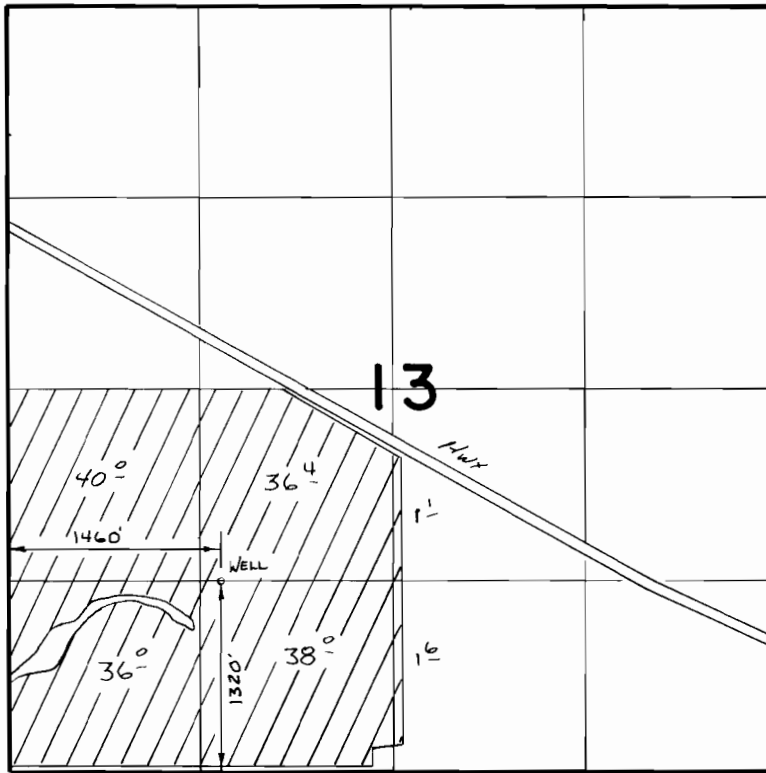

Scale 1" = 1320'

FINAL PROOF SURVEY UNDER

Application No. ~~G:9104~~ Permit No. ~~G:8452~~
IN NAME OF

.....LEE.....A.....WALLACE.....

Surveyed ...5:10... 1988, by J.M. WARREN.....