
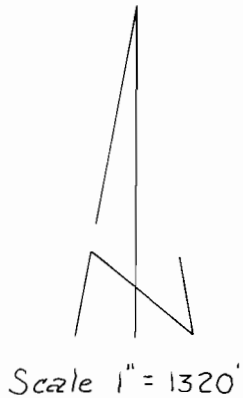


T. 25S., R. 33E., W.M.

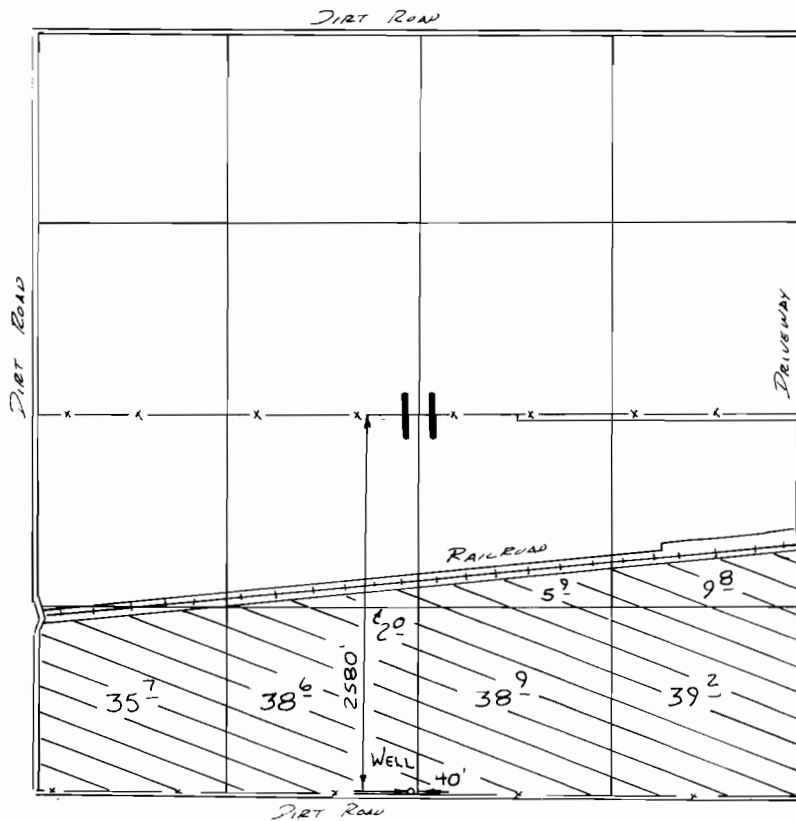

FINAL PROOF SURVEY UNDER

Application No. **G:9946** Permit No. **G:9654**...
IN NAME OF

.....**JOHN S. WILLIAMS**.....

Surveyed ...**5-8**..... 19**88**, by **V.L. Chivers**.....