


T. 39 S., R. 5 W., W. M.

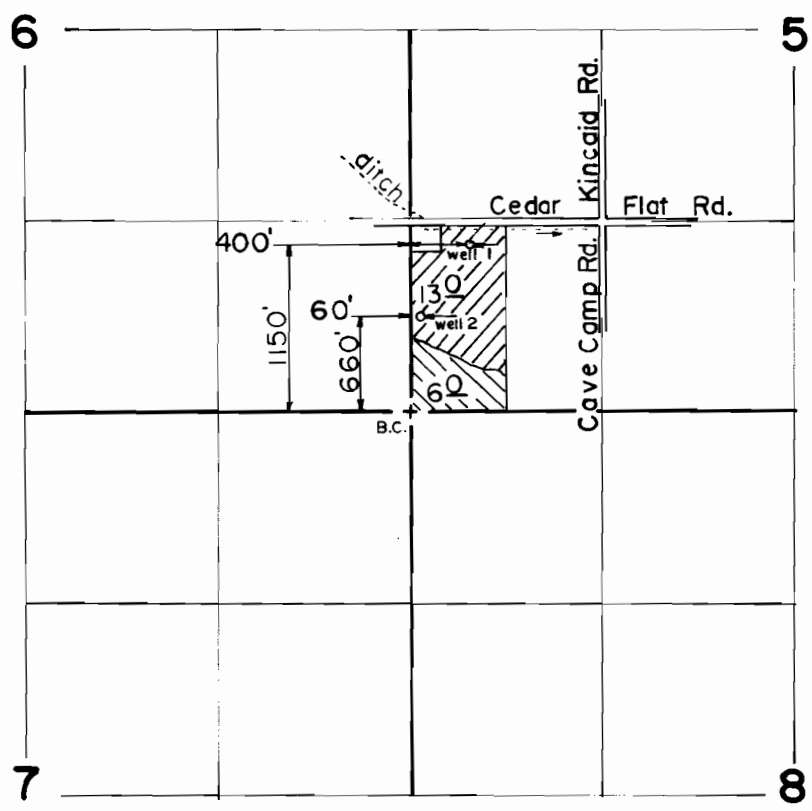

Scale: 1" = 1320'

FINAL PROOF SURVEY UNDER

Application No. G-10546 Permit No. G-9697
IN NAME OF

ANTHONY A. NEMETH

Surveyed JUL. 11, 1988, by B. S. JAMES