


T. 38 S., R. 5 W., W. M.

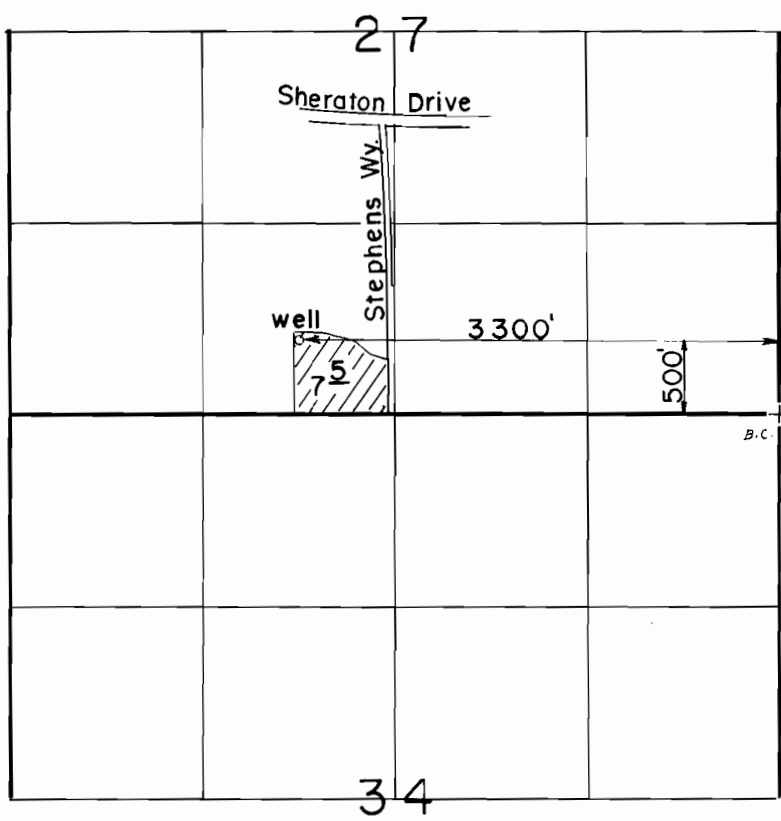

Scale: 1" = 1320'

FINAL PROOF SURVEY
UNDER

Application No. G-10555 Permit No. G-9748
IN NAME OF

MARK W. WHEELER

Surveyed AUG. 8, 1988, by B. S. JAMES