


T.1N.&1S., R.13E., W.M.

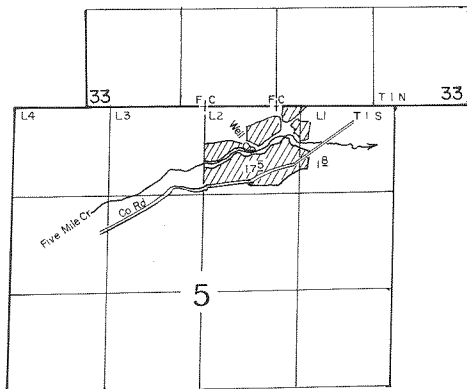

Well Located 530'S & 580'E From The NW Corner Of Section 5

SCALE 1"=1320'

FINAL PROOF SURVEY UNDER

Application No. G-11014. Permit No. G-10183....
IN NAME OF

.....JOHN.....N.....WILSON.....

Surveyed JUNE 7, 1988., by T.M. WARREN.....