

67729


RECEIVED

SEP 13 1984

WATER RESOURCES DEPT  
SALEM, OREGON

138800

T. 37S. R. 11E. W.M.

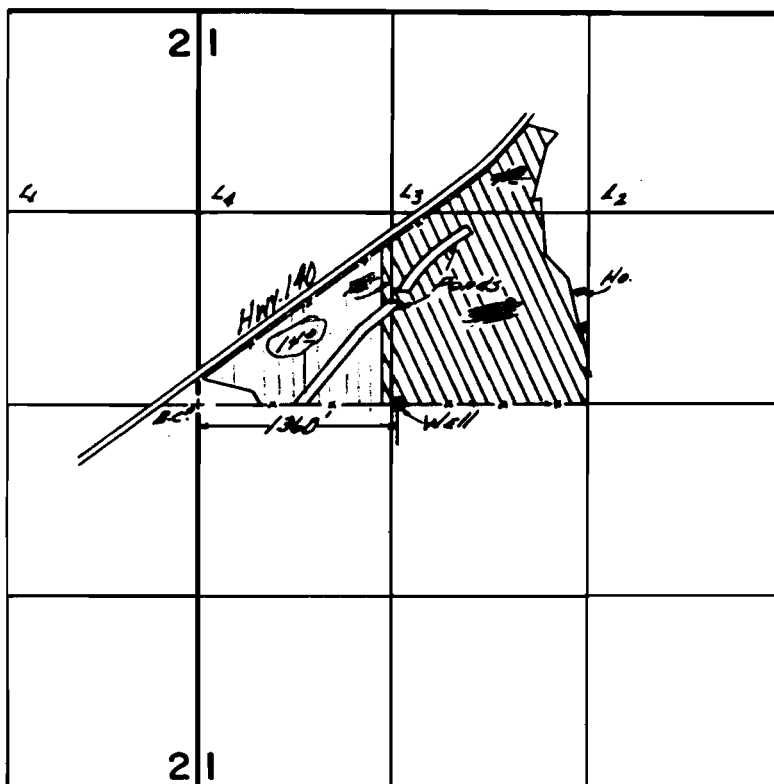

Whiskey Creek Well

FINAL PROOF SURVEY  
UNDER

Application No. ~~G-11308~~ Permit No. ~~G-10431~~  
IN NAME OF

JOHN M. KEMPER

Surveyed ~~SEP 12 1983~~ by ~~C.R. RODRIGUEZ~~

Application No. G-11308  
Permit No. G10431