


Swan Lake Misc. Wells
SCALE 1" = 10'

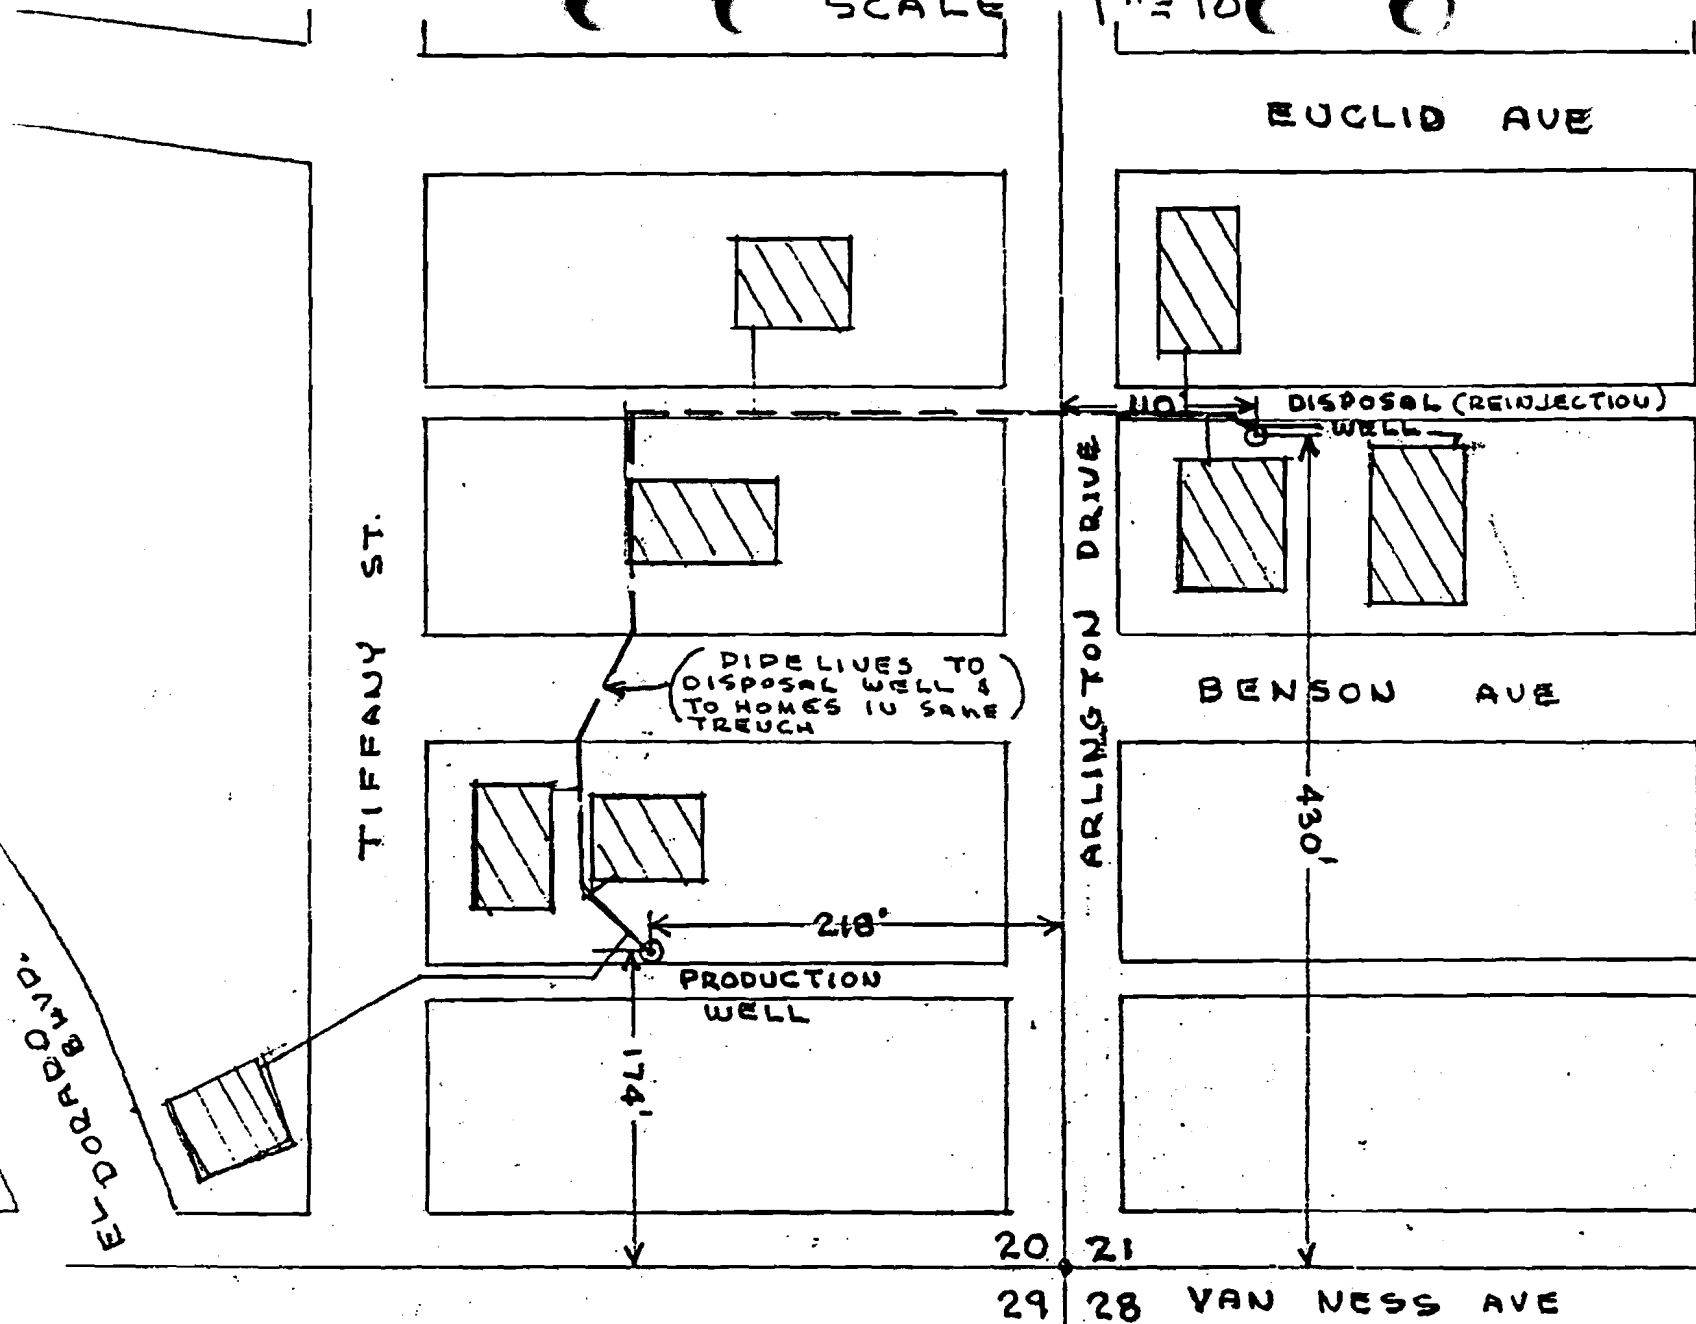

RECEIVED
MAY 29 1986
WATER RESOURCES DEPT
SALEM, OREGON

Application No. 2-11512
Permit No. G10620

6-10000
67730