


T. 39 S., R. 4 W., W. M.

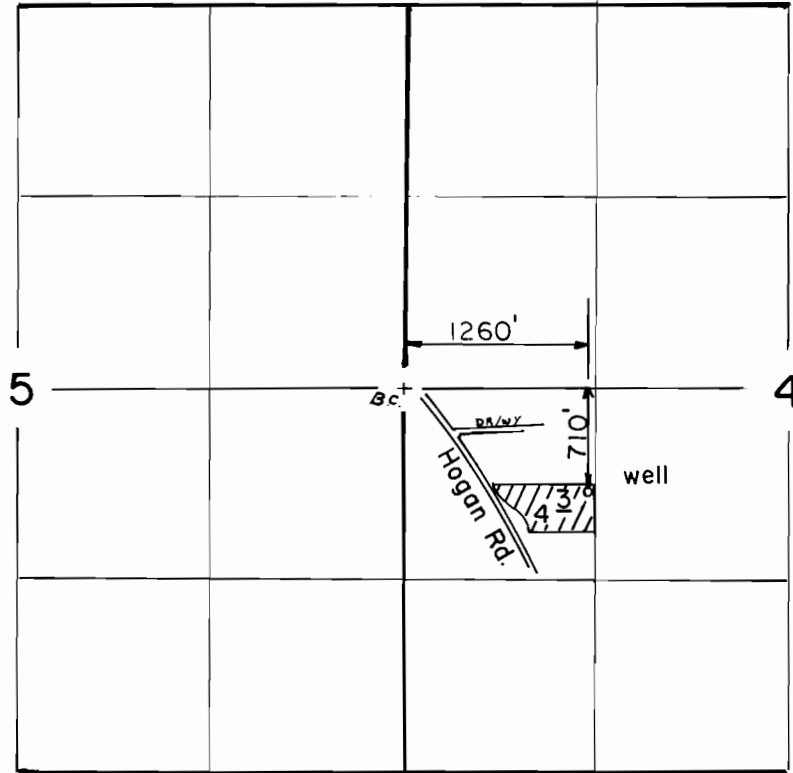

Scale: 1" = 1320'

FINAL PROOF SURVEY UNDER

Application No. G:11574 Permit No. G:10693
IN NAME OF

CHARLES A. WETLESEN, C. VINCENT & KATHERINE MERCADANTE

Surveyed JAN. 28. 1991., by L. M. JOACHIMS