


# T.2S., R.4E., W.M.

THIS MAP IS FOR THE PURPOSE OF IDENTIFYING THE LOCATION OF THE WATER RIGHT ONLY AND IS NOT INTENDED TO PROVIDE LEGAL DIMENSIONS OR LOCATIONS OF PROPERTY OWNERSHIP LINES.

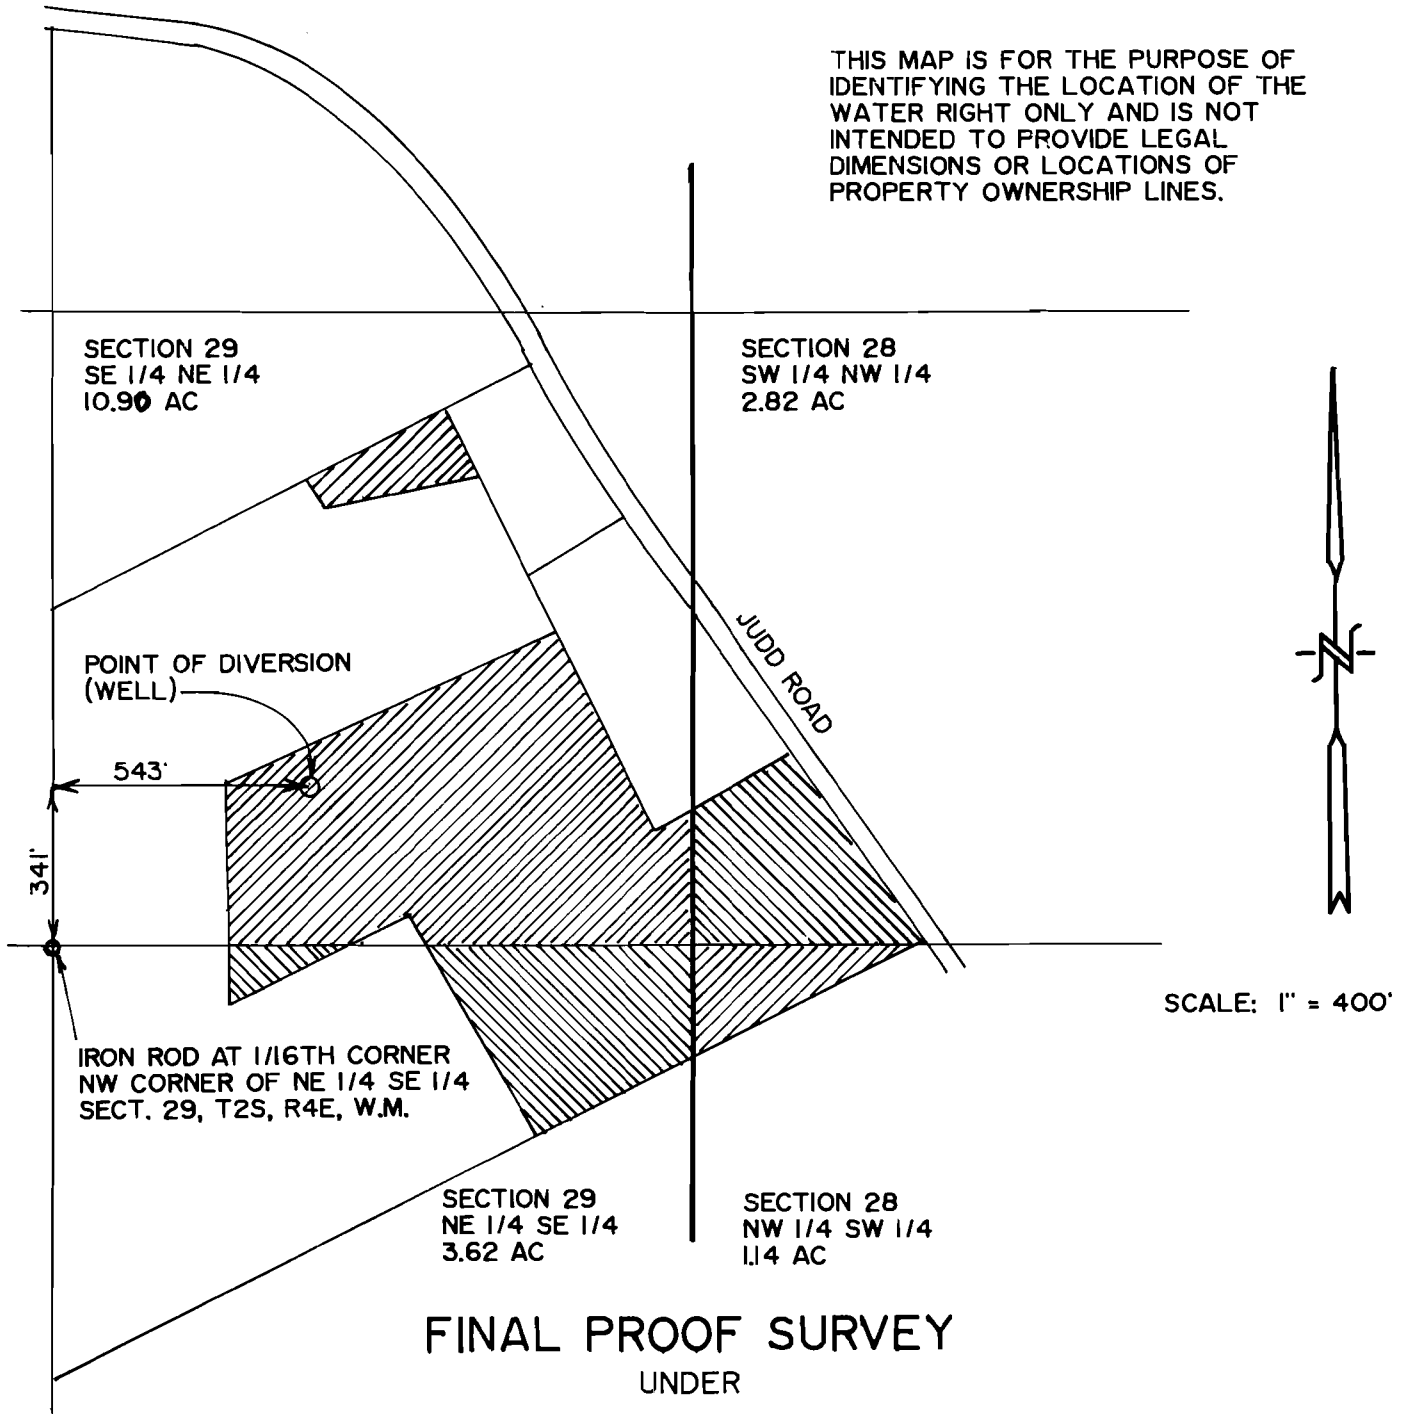

## FINAL PROOF SURVEY UNDER

APPLICATION NO. G12285 PERMIT NO. G11189

IN THE NAME OF

### SANDY FARMS, INC.

SURVEYED DEC. 6, 1991, BY ANDREW M. KLEIN

