


T. 28 S., R. 1 E., W. M.

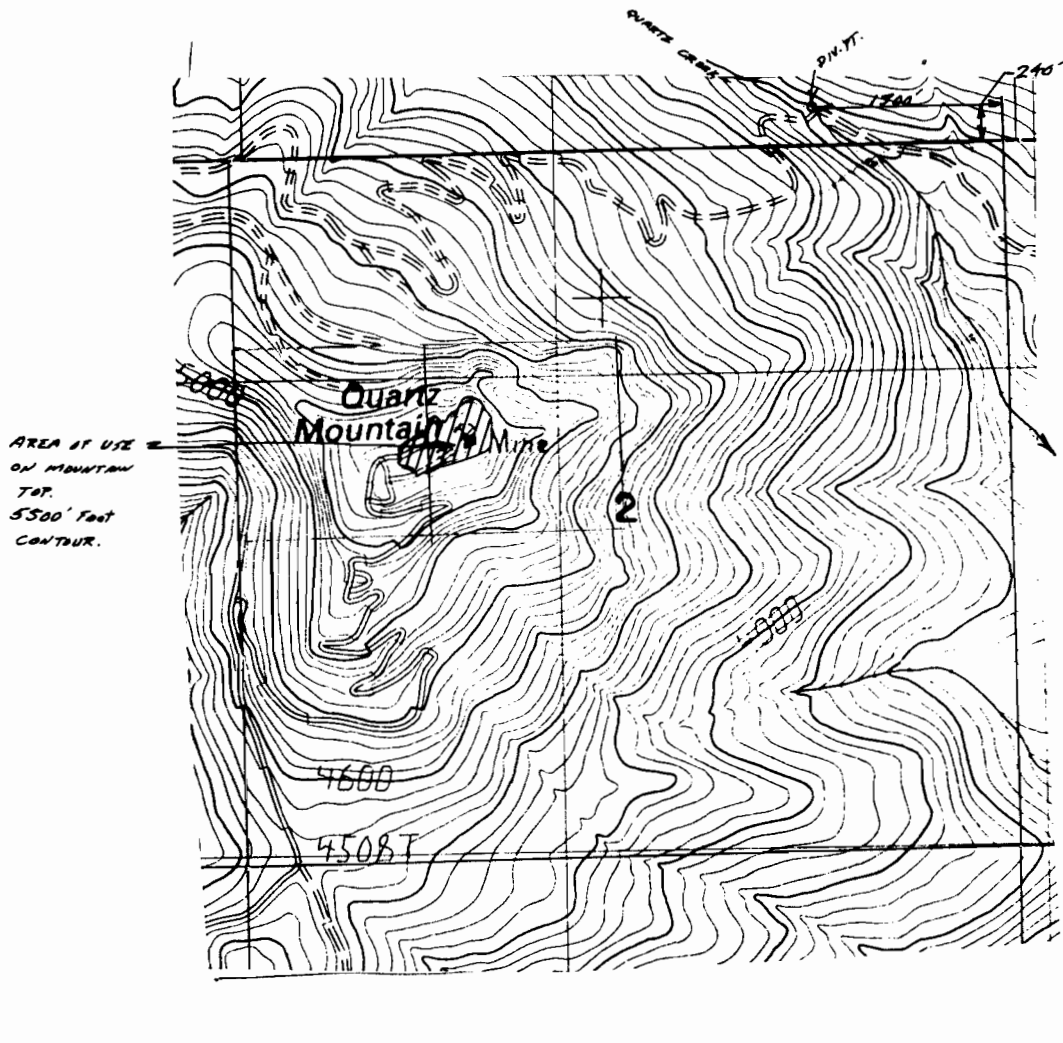

Scale 1"=1320'

FINAL PROOF SURVEY UNDER

Application No. 34558 Permit No. 27142....
IN NAME OF

ROY & G. D. RANNELLS

Surveyed June 2, 1922, by S. James