


T. 29S., R. 1E., W. M.

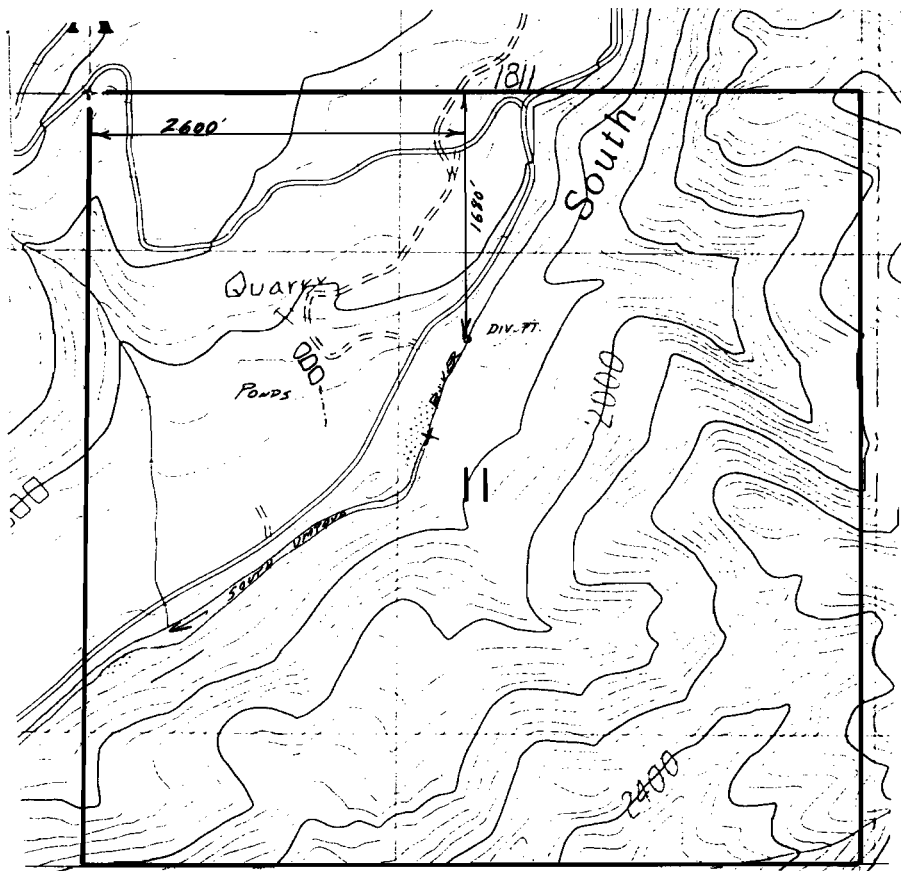

Scale 1" = 1320'



**FINAL PROOF SURVEY
UNDER**

Application No. 40522 Permit No. 30182.....
IN NAME OF

...ROY & G. D. RANNELLS.....

Surveyed June 2, 1992, by S. James.....