


T. 30 S., R. 2 W., W. M.

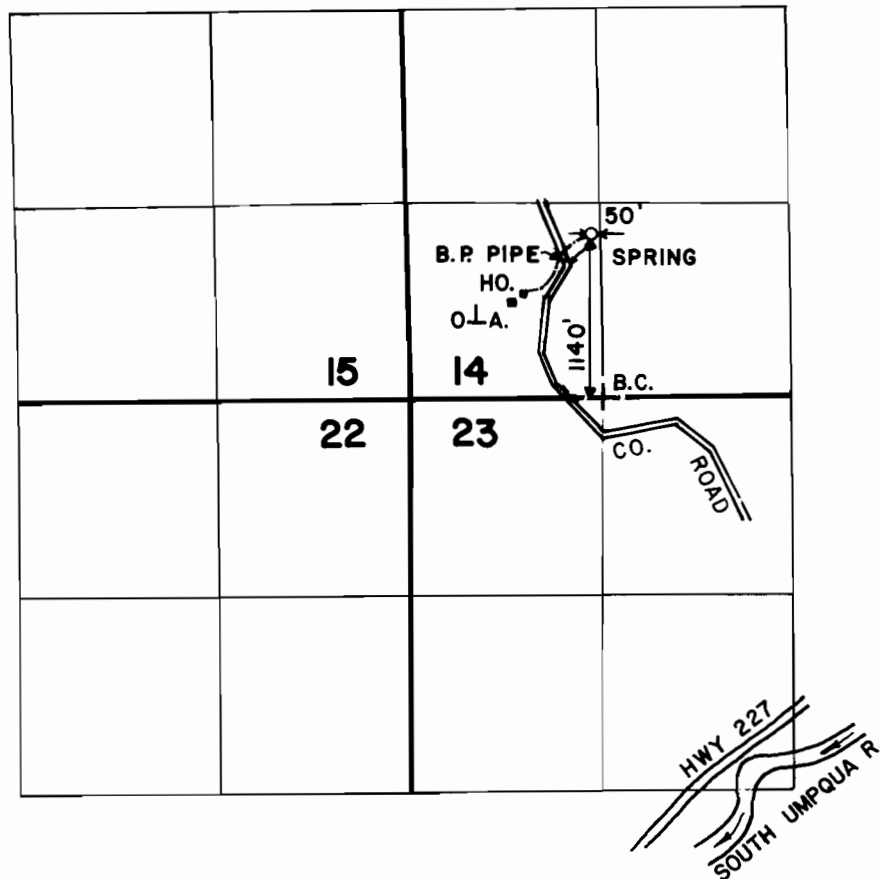

SCALE: 4" = 1 MILE

FINAL PROOF SURVEY
UNDER

Application No. 45386 Permit No. 33885
IN NAME OF

CHRIS RUSCH

Surveyed SEPT. 18 1985, by J.M. SCHMORDE