


T 22 S R 4 W WM

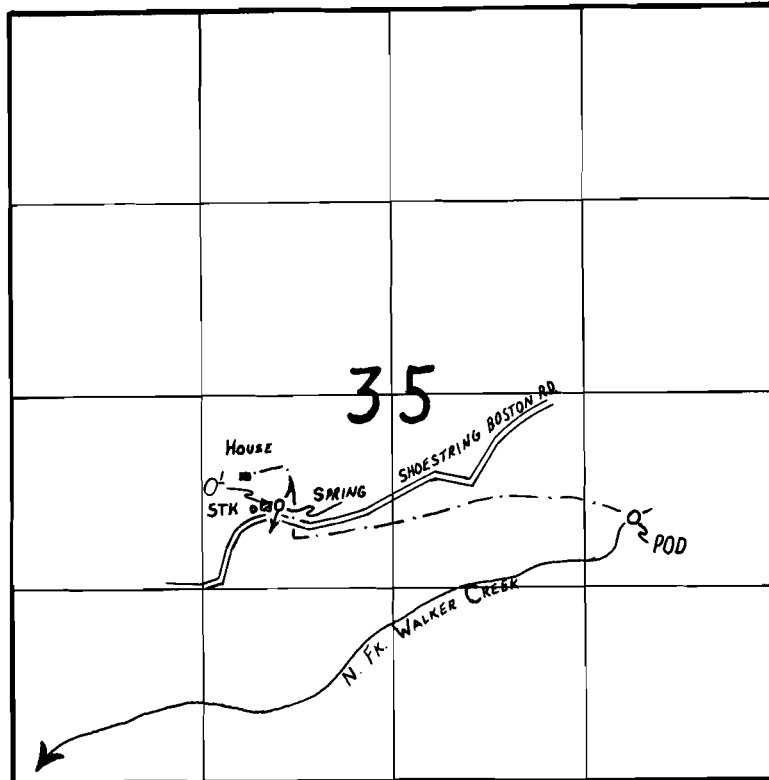

1" = 1320'

POD IS LOCATED 870' S AND 1670' E; SPRING IS LOCATED 750' S AND 770' W BOTH BEING LOCATED FROM THE CENTER 1/4 OF SECTION 35

FINAL PROOF SURVEY UNDER

Application No. 54796. Permit No. 41112....
IN NAME OF

.....IVAN L. BEER.....

Surveyed Aug. 28 1990., by T.M. WARREN....