


# T. 1 N. R. 48 E. W. M.

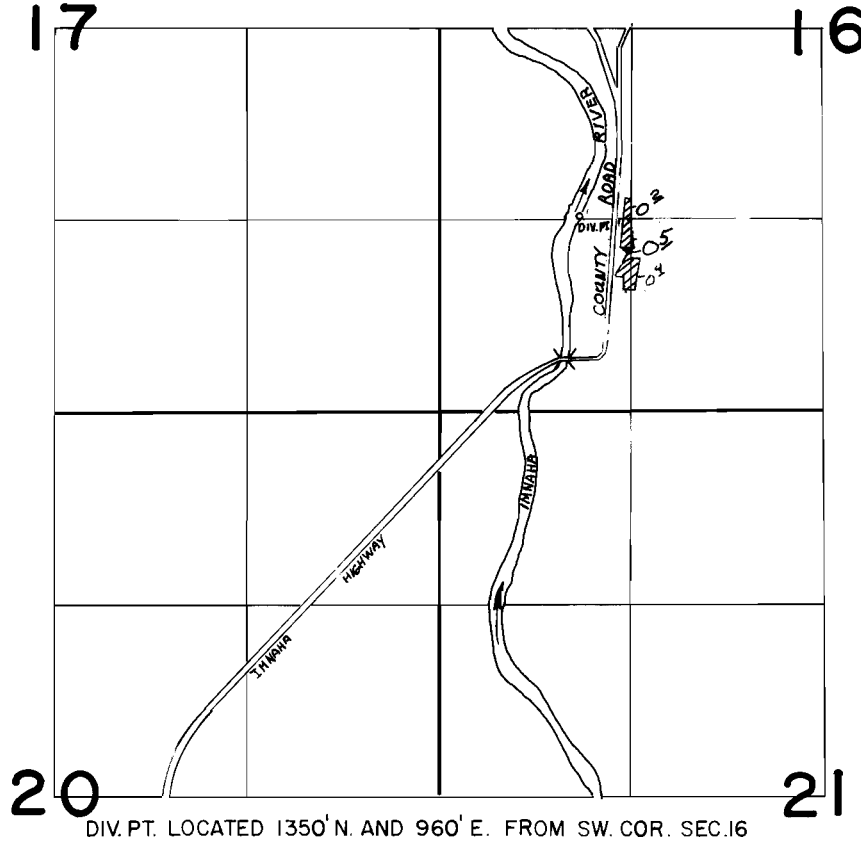

SCALE: 1"=1320'



## FINAL PROOF SURVEY UNDER

Application No. 55007.. Permit No. 41269.....  
IN NAME OF

.....**W. G. BUCHANAN**.....

Surveyed ..8-7..... 1984., by ..V.L. CHURCH.....