


T.5S.R.3W.W.M.

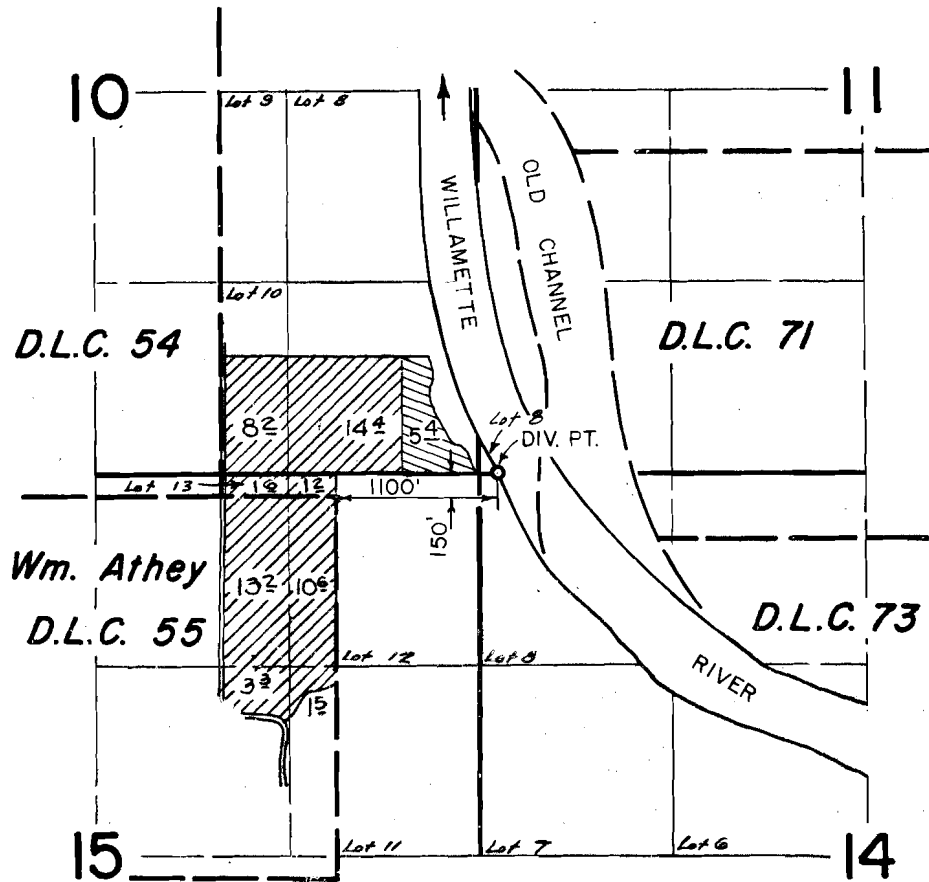

FINAL PROOF SURVEY  
UNDER

TRANSFER NO. 3681  
APPLICATION NO. 55961 PERMIT NO. 42114  
IN NAME OF

ROGER HILDEBRANDT

SURVEYED MAY 28, 1980, BY *dl Brown*