


T.5S.R.3W.W.M.

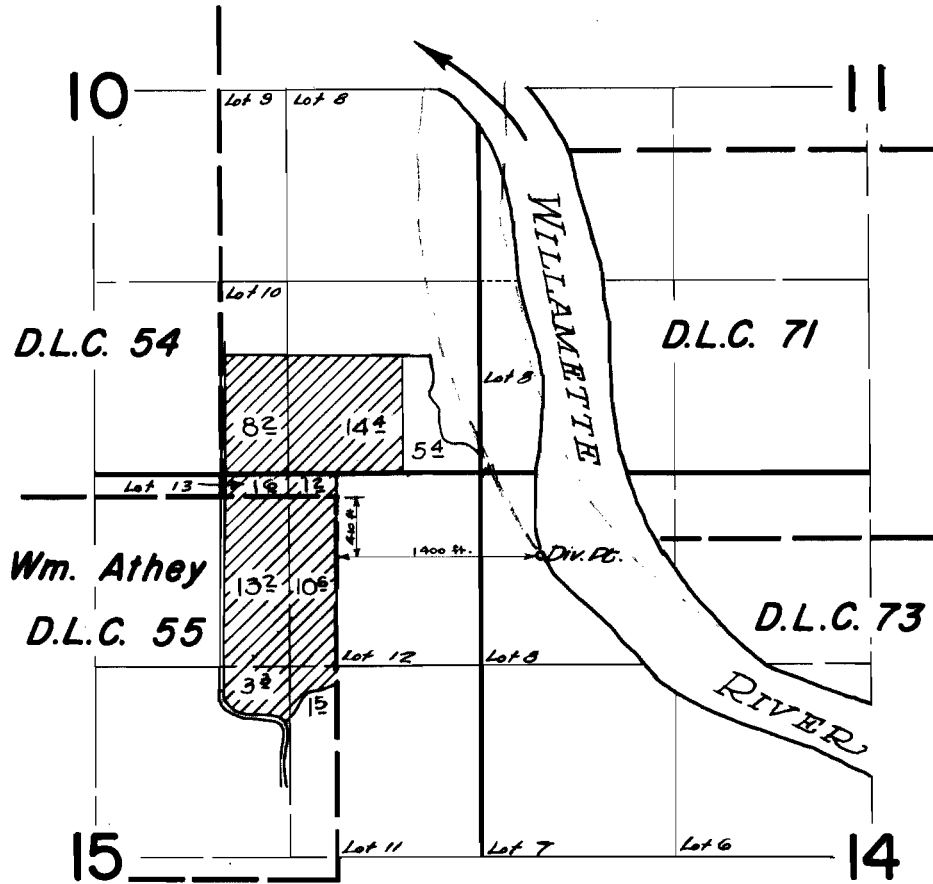

FINAL PROOF SURVEY UNDER

Application No. **39235**... Permit No. **29234**...
IN NAME OF

DONALD LEE & PHYLLIS TOMPKINS

Surveyed *August 26 1964*, by *R. Jackson*