


T. 22 S., R. 8 W., W.M.

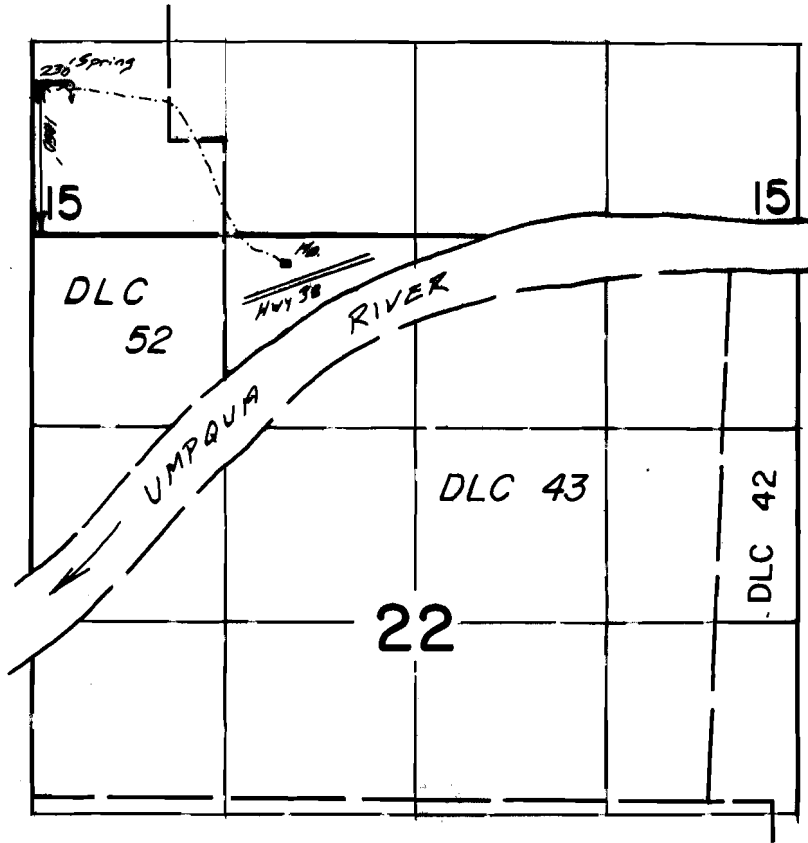

Scale 1" = 1320'

FINAL PROOF SURVEY
UNDER

Application No. 56890. Permit No. 42816.....
IN NAME OF

EVERETT WAYNE HIGGINS

Surveyed Aug..8... 1991.., by B.S..JAMES.....