

7747
67745



BADURA

WATER PERMIT APPLICATION # 58467

27 | 26
34 | 35

Sec. 35 T35S R6E WM

Scale 1" = 400ft

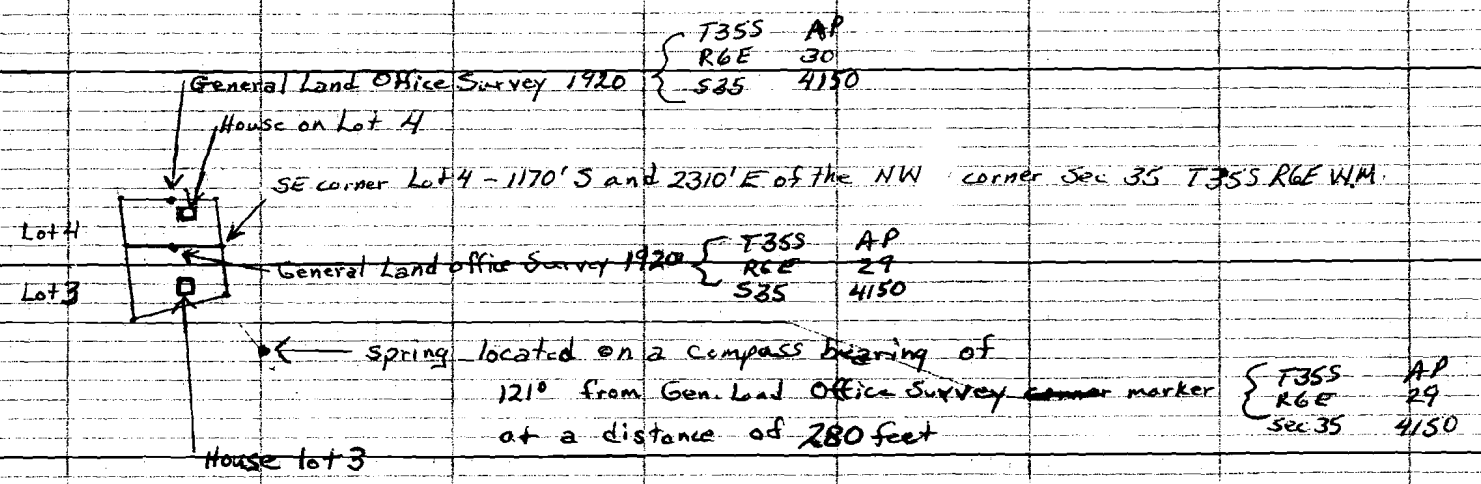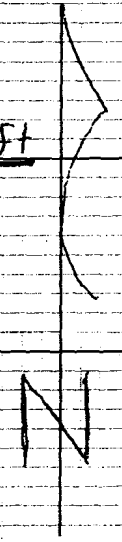

RECEIVED

MAY 31 1979

WATER RESOURCES DEPT.
SALEM, OREGON

Application No. 58467

Permit No. 44164

c 35