
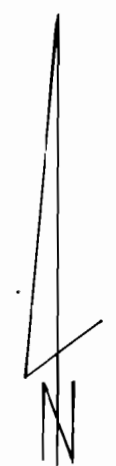


T 7 S., R. 42 E., W.M.

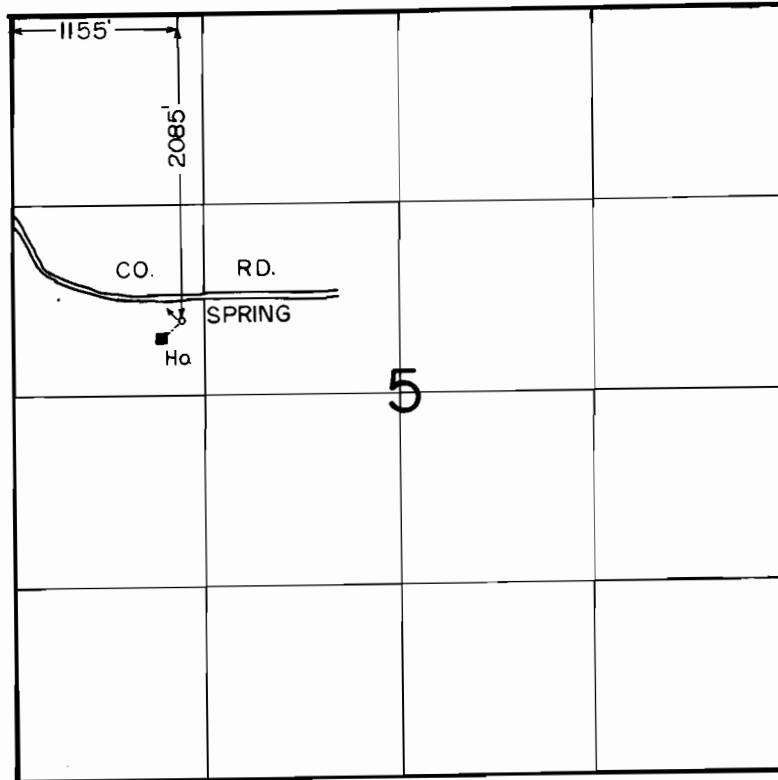

1" = 1320'

FINAL PROOF SURVEY
UNDER

Application No. 61245.. Permit No. 47270.....

IN NAME OF

DANA P. STONE

Surveyed JUNE 20 90 by V L CHURCH
..... 19....., by

12-31-90 DSM
CHAIN SURVEY