


T.3S. R.45E.; W.M.

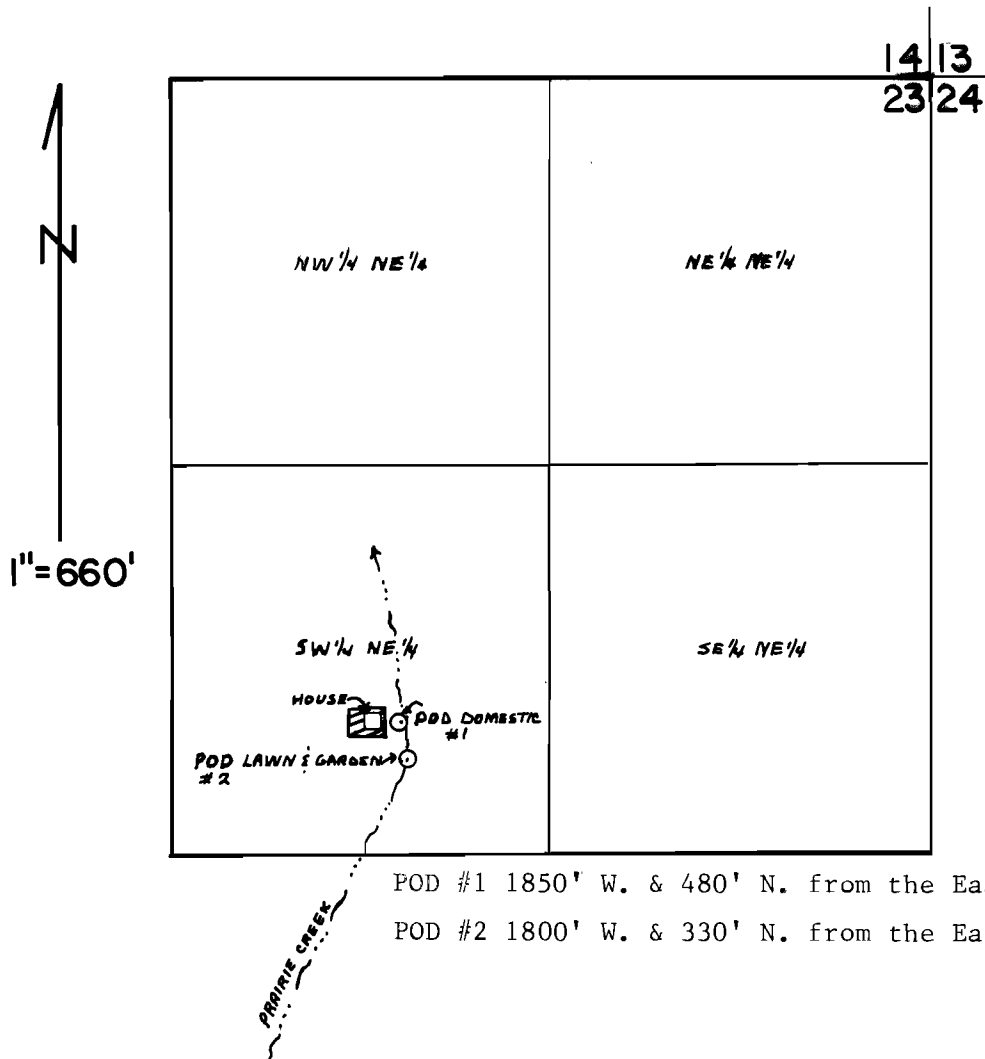

FINAL PROOF SURVEY UNDER

Application No. ~~61524~~. Permit No. ~~45714~~...
IN NAME OF

.....
Surveyed ~~10-6~~..... 19~~90~~.., by ~~H. Kemp~~.....

DRAFTED
2-20-92
June Miller