
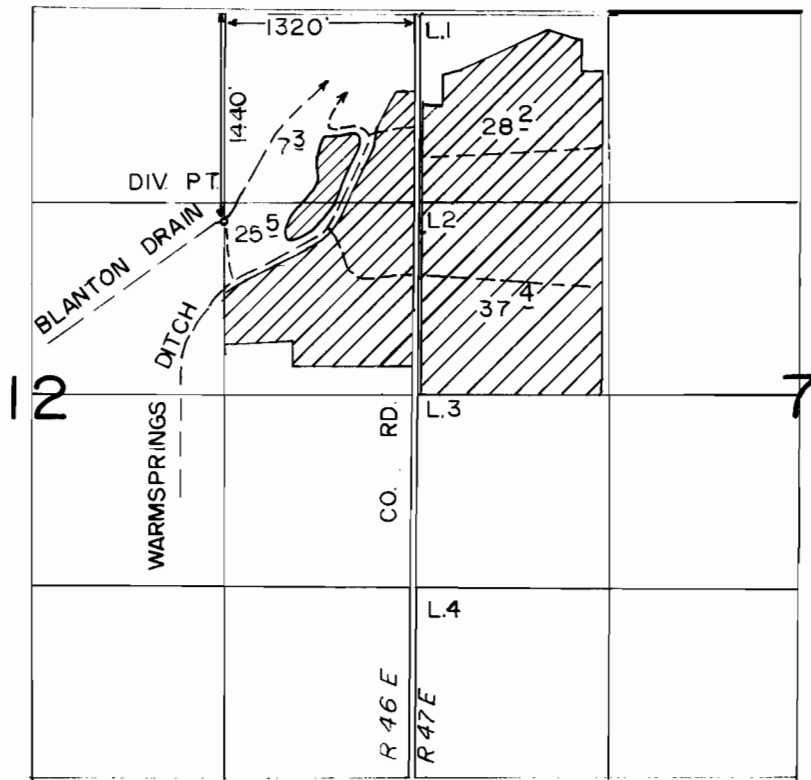


T. 18 S., R. 46 & 47 E., W.M.

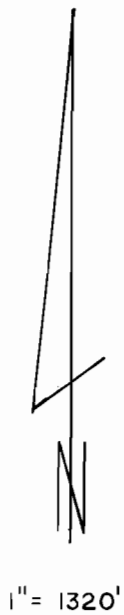

FINAL PROOF SURVEY
UNDER

Application No. 61556 Permit No. 45922
IN NAME OF

JAMES M. & SHARON WADA & LOREN C. COX

Surveyed MARCH 6 1986, by L. TOLL
MAY 31 1990 V. CHURCH

12-28-90 DSM
41045 - 478-13R