


T.21S., R.4W., W.M.

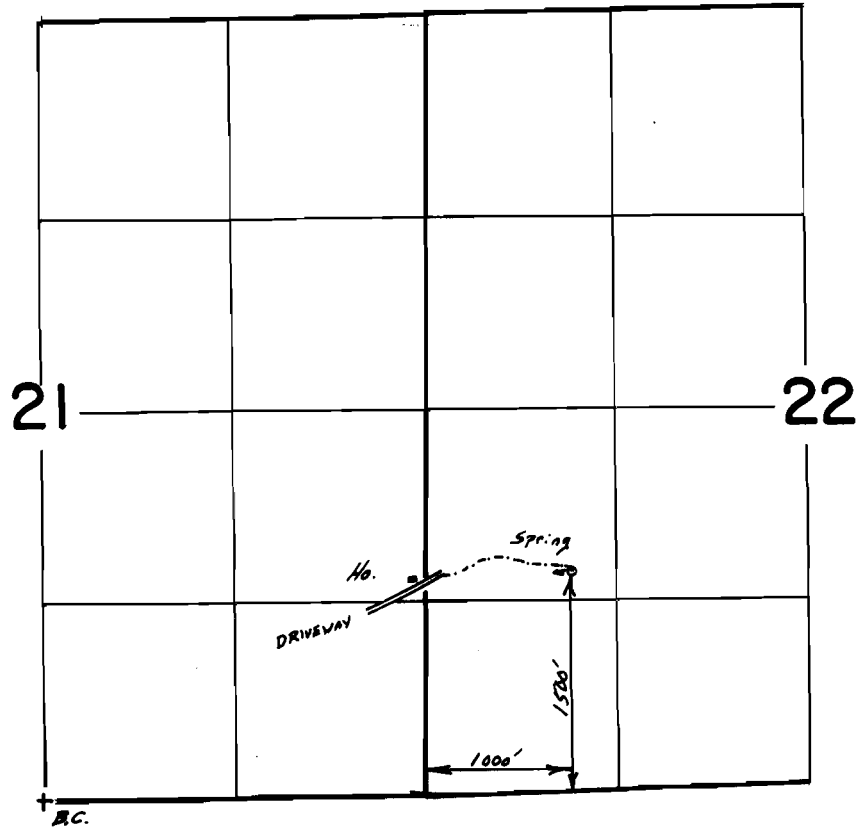

Scale 1"= 1320'

FINAL PROOF SURVEY
UNDER

Application No. 63222 Permit No. 46705...
IN NAME OF

.....ROBERT W. STRAUB.....

Surveyed Aug. 22, 1991, by B.S. JAMES.....