
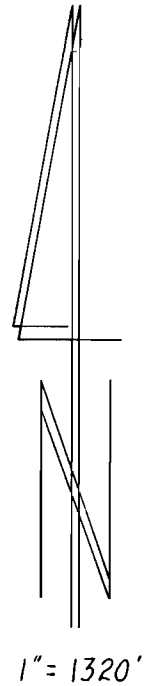


T. 11 S., R. 5 W., W.M.

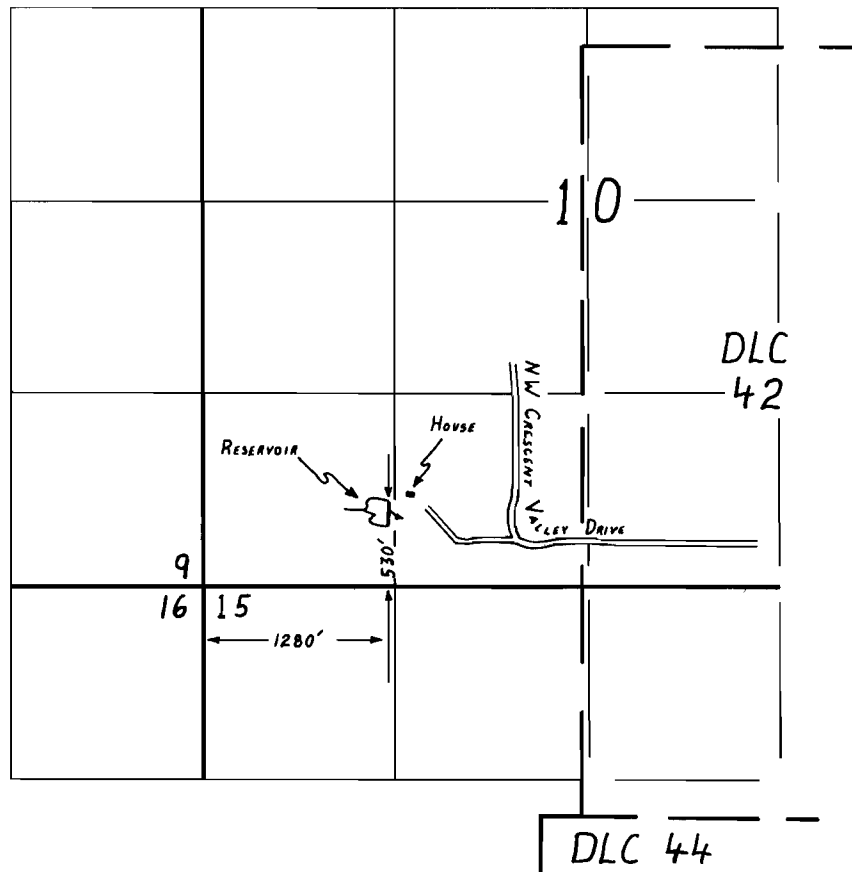

FINAL PROOF SURVEY

UNDER

Application No. R-63455 & 63456 Permit No. R-8450 & 46808
IN NAME OF

MAXINE M. THOMPSON

Surveyed MARCH 3, 1991, by R.W. Klassen