


T. 26 S., R. 6 W., W.M.

SECTIONS 28 and 33

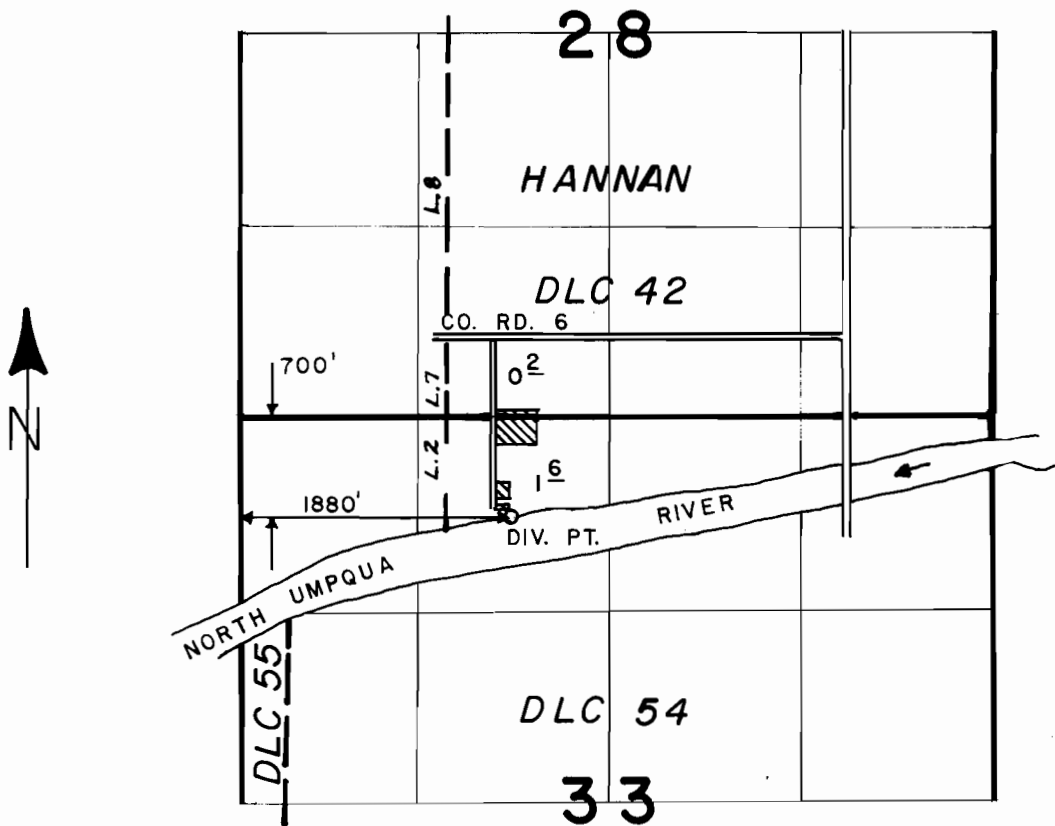

SCALE: 4" = 1 MILE

FINAL PROOF SURVEY UNDER

Application No. 63564 Permit No. 46834
IN NAME OF

RONALD G. FRASHOUR

Surveyed MAY 27 1987, by J. M. SCHMORDE

*ERROR
on App# on final
63546
not
644*