


T. 28 S., R. 6 W., W. M.

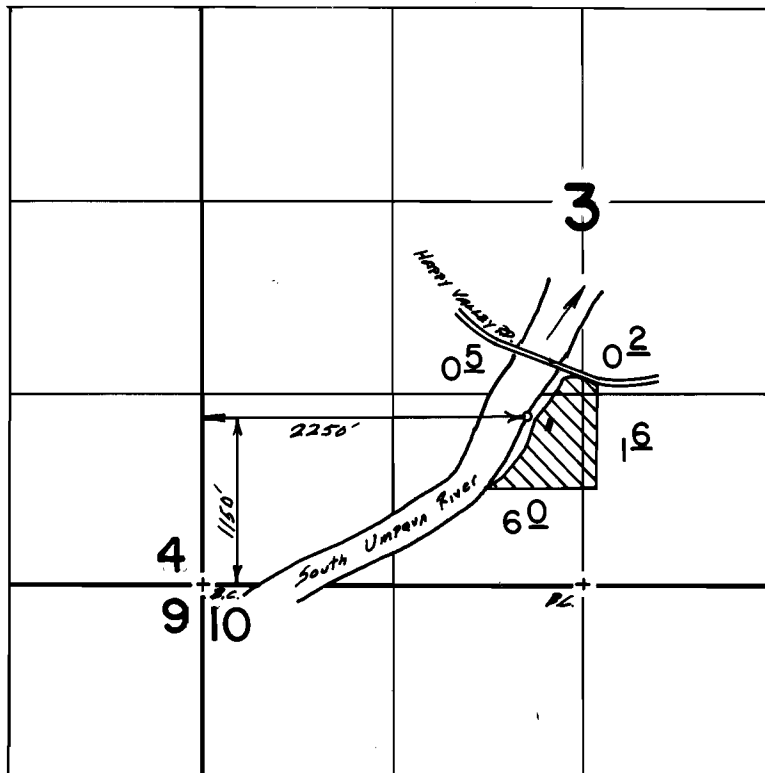

Scale 1" = 1320'

FINAL PROOF SURVEY
UNDER

Application No. 63684 Permit No. 46873...
IN NAME OF

..... AGNES A. FULLERTON

Surveyed Aug 2 & 6, 1990, by B.S. JAMES & L.M. JOACHIMS