


T 16S R 7W WM

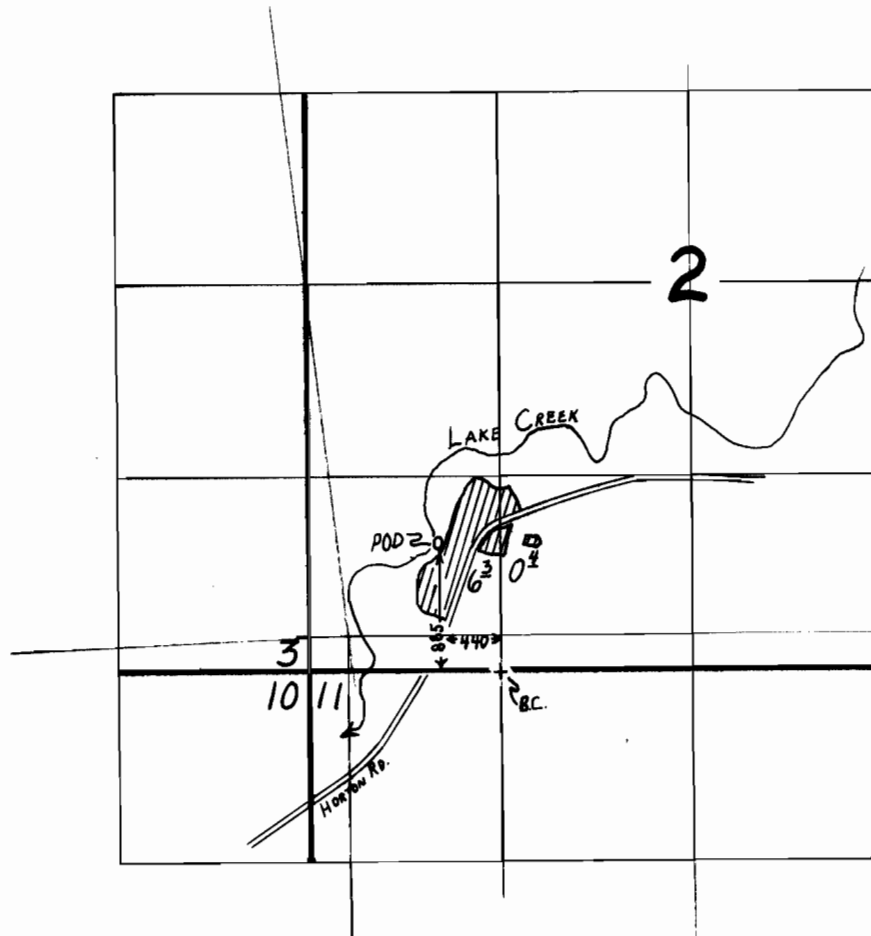

1" = 1320'

FINAL PROOF SURVEY
UNDER

Application No. ~~64625~~ Permit No. ~~47543~~.....
IN NAME OF

.....WALLACE N. DERBY.....

Surveyed Aug. 6.... 1990., by T. M. WARREN.....