


T19S R1W WM

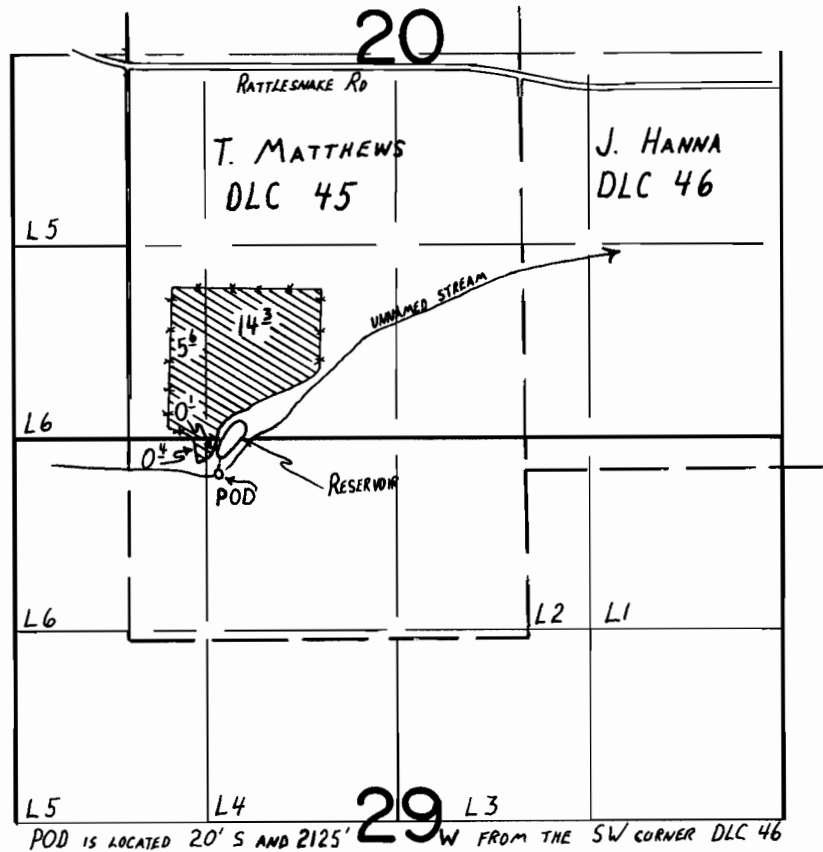

1" = 1320'

FINAL PROOF SURVEY UNDER

R-65061 R-8887
Application No. 65062... Permit No. 47798.....
IN NAME OF

GIUSTINA LAND & TIMBER COMPANY.....

Surveyed Aug. 28... 1990, by T.M. WARREN.....