


T19S RIW WM

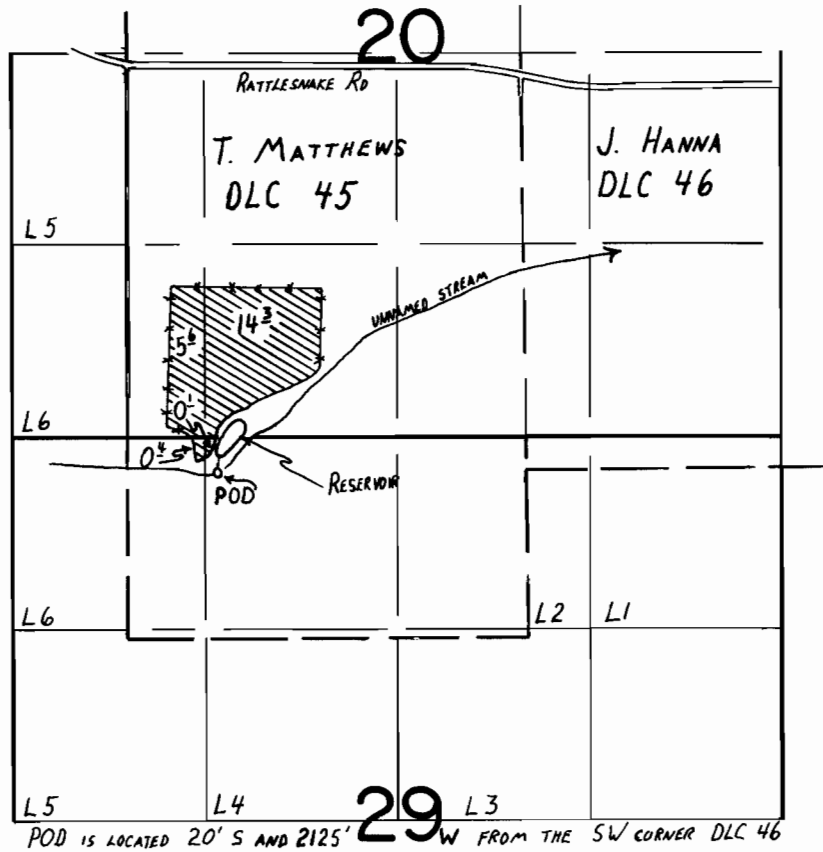

FINAL PROOF SURVEY UNDER

R-65061 R-8887
 Application No. 65062... Permit No. 47798.....
 IN NAME OF
 GIUSTINA LAND & TIMBER COMPANY.....
 Surveyed Aug. 28... 1990., by T.M. WARREN.....